


Door Schedule		
Mark	Type	Material
102	60" x 96"	
104A	28" GLASS	GLASS
104B	28" GLASS	GLASS
105	28" x 96"	WOOD
106A	36" x 96"	OPENING
106B	36" x 96"	OPENING
108	16" x 8" Sliding Glass Door	GLASS
109A	36" x 96"	WOOD
109B	18" x 8"	GARAGE
110A	36" x 96"	WOOD
110B	36" x 96"	GLASS
111A	36" x 96"	WOOD
111B	9" x 8"	GARAGE
111C	36" x 96"	WOOD
112A	28" x 96"	WOOD
112B	28" x 96"	WOOD
113	32" x 96"	WOOD
114	28" x 96"	WOOD
115A	16" x 8" Sliding Glass Door	GLASS
115B	16" x 8" Sliding Glass Door	GLASS
117	16" x 8" Sliding Glass Door	GLASS
118	28" x 96"	WOOD
119	28" x 96"	WOOD
120A	48" x 96"	WOOD
120B	60" x 96"	
121	28" x 96"	WOOD
122A	28" x 96"	WOOD
122B	28" x 96"	WOOD
123A	32" x 96"	WOOD
123B	32" x 96"	WOOD
125A	48" x 96"	WOOD
125B	28" x 96"	WOOD
126A	32" x 96"	WOOD
126B	60" x 96"	
126C	60" x 96"	
127A	28" x 96"	
127B	36" x 96"	
203A	28" x 96"	
203B	28" x 96"	
204	32" x 96"	
205	28" x 96"	
207	32" x 96"	
208	28" x 96"	
209	28" x 96"	
211	32" x 96"	
212	28" x 96"	
213	28" x 96"	
301A	46" x 96"	
301B	36" x 96"	GLASS
301C	6"x8" Sliding Glass Door	
301D	6"x8" Sliding Glass Door	
302	32" x 96"	WOOD
303	32" x 96"	WOOD
304A	36" x 96"	WOOD
304B	36" x 96"	GLASS
304C	9" x 9"	
401A	28" x 96"	WOOD
402A	28" x 96"	WOOD
403	28" x 96"	WOOD

Window Schedule			
Mark	Type	Sill Height	Head Height
102A	3 Panel 36"x96"	0"	8' - 0"
102B	3 Panel 24"x96"	0"	8' - 0"
102C	3 Panel 24"x96"	0"	8' - 0"
103A	3 Panel 36"x96"	0"	8' - 0"
103B	3 Panel 36"x96"	0"	8' - 0"
103C	3 Panel 36"x96"	0"	8' - 0"
103D	3 Panel 36"x96"	0"	8' - 0"
103E	3 Panel 36"x96"	0"	8' - 0"
103F	3 Panel 36"x96"	0"	8' - 0"
107A	3 Panel 36"x72" S.H.	2' - 0"	8' - 0"
107B	3 Panel 36"x72" S.H.	2' - 0"	8' - 0"
114E	72" x 12"	7' - 0"	8' - 0"
119	3 Panel 36"x96"	0"	8' - 0"
122	48" x 12" BLACK	7' - 0"	8' - 0"
124	3 Panel 36"x72" S.H.	2' - 0"	8' - 0"
201A	3 Panel 36"x72" S.H.	2' - 0"	8' - 0"
201B	3 Panel 36"x72" S.H.	2' - 0"	8' - 0"
201C	3 Panel 36"x72" S.H.	2' - 0"	8' - 0"
202A	3 Panel 36"x96"	0"	8' - 0"
202B	3 Panel 36"x96"	0"	8' - 0"
202C	3 Panel 36"x96"	0"	8' - 0"
202D	3 Panel 36"x96"	0"	8' - 0"
202E	3 Panel 36"x96"	0"	8' - 0"
202F	3 Panel 36"x96"	0"	8' - 0"
204	3 Panel 36"x72" S.H.	2' - 0"	8' - 0"
207	3 Panel 36"x72" S.H.	2' - 0"	8' - 0"
210A	60" x 24"	7' - 0"	9' - 0"
210B	60" x 24"	7' - 0"	9' - 0"
210C	60" x 24"	7' - 0"	9' - 0"
210D	60" x 24"	7' - 0"	9' - 0"
211A	3 Panel 36"x72" S.H.	2' - 0"	8' - 0"
211B	3 Panel 36"x72" S.H.	2' - 0"	8' - 0"
211OO	3 Panel 36"x72" S.H.	2' - 0"	8' - 0"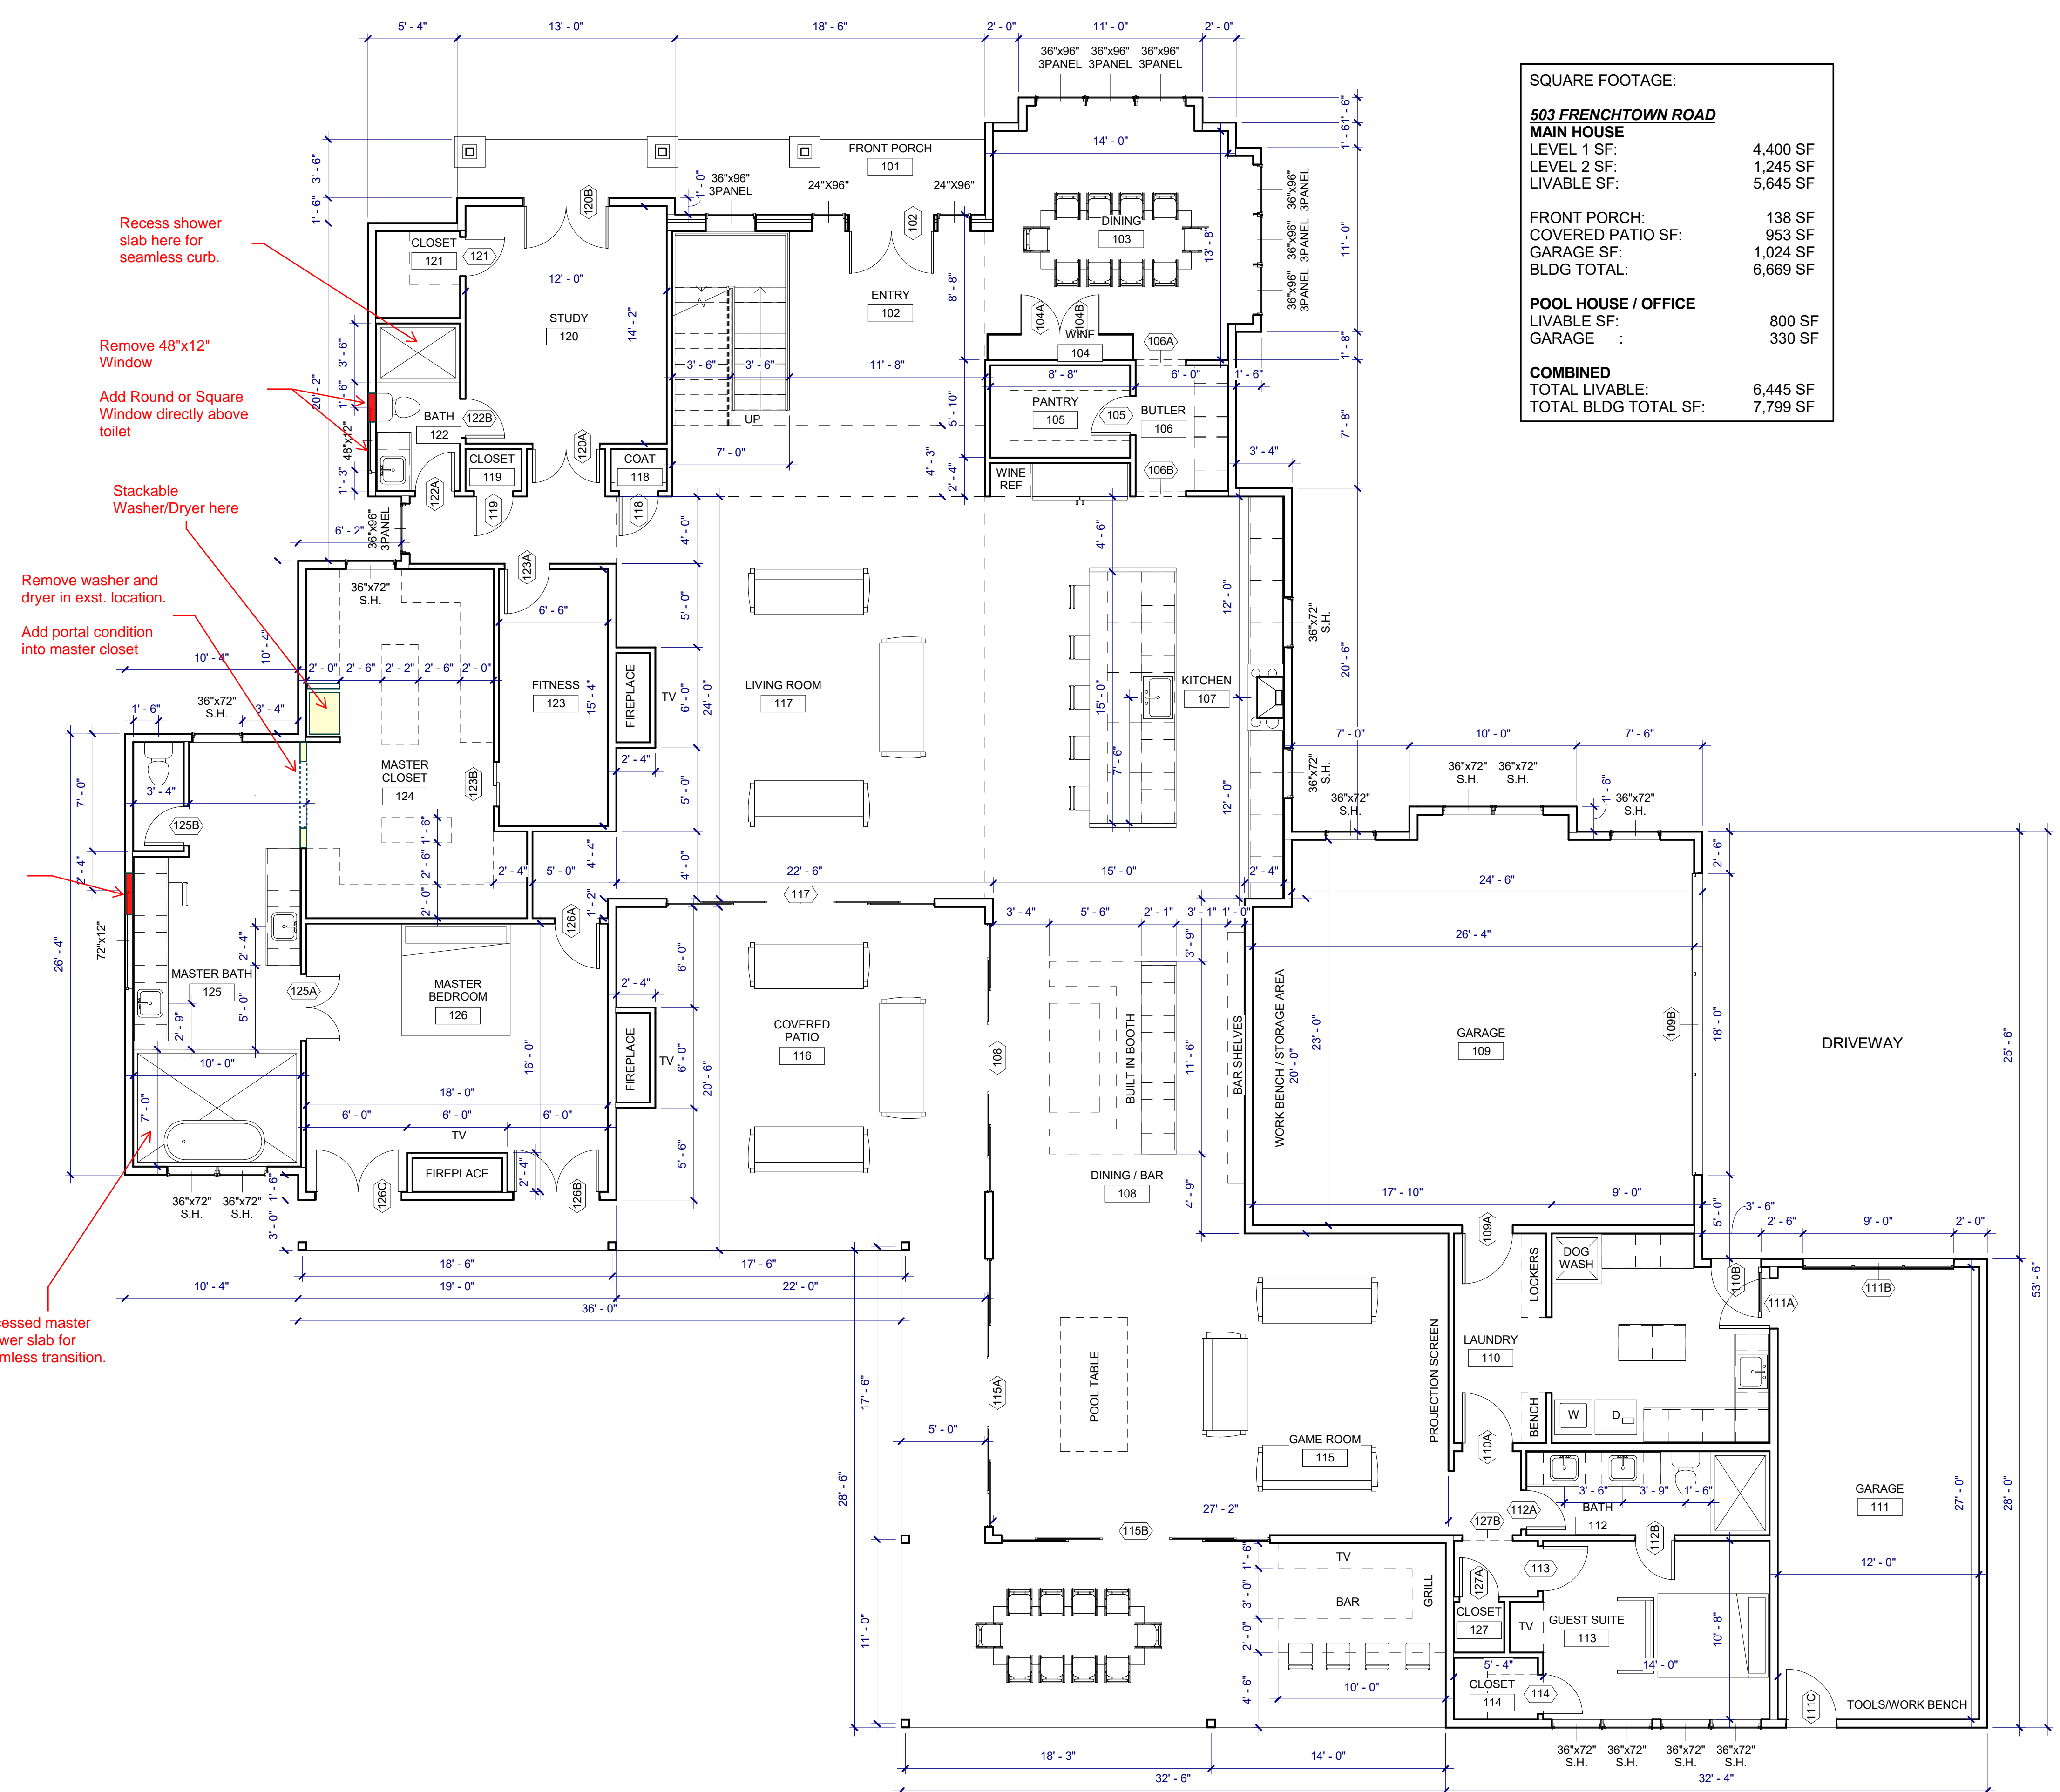
**SQUARE FOOTAGE:**

**503 FRENCHTOWN ROAD**

**MAIN HOUSE**  
 LEVEL 1 SF: 4,400 SF  
 LEVEL 2 SF: 1,245 SF  
 LIVABLE SF: 5,645 SF

**FRONT PORCH:** 138 SF  
**COVERED PATIO SF:** 953 SF  
**GARAGE SF:** 1,024 SF  
**BLDG TOTAL:** 6,669 SF

**POOL HOUSE / OFFICE**  
 LIVABLE SF: 800 SF  
 GARAGE : 330 SF

**COMBINED**  
 TOTAL LIVABLE: 6,445 SF  
 TOTAL BLDG TOTAL SF: 7,799 SF

**LEVEL 1 FLOOR PLAN**  
 SCALE: 3/16" = 1'-0"

**503 FRENCHTOWN ROAD**  
**ARGYLE, TX 76226**

THESE PLANS ARE THE PROPERTY OF RYAN JACOBSON DESIGN LLC AND ARE NOT TO BE REPRODUCED, TRACED, OR REUSED FOR CONSTRUCTION WITHOUT THE WRITTEN PERMISSION OF RYAN JACOBSON DESIGN LLC. THESE PLANS ARE INTENDED TO PROVIDE ALL PROSPECTIVE CONTRACTORS, AND/OR BUILDING MANUFACTURERS THE NECESSARY INFORMATION NEEDED TO DESIGN, BID, AND CONSTRUCT THIS BUILDING. OWNER SHALL VERIFY AND CHECK ALL ASPECTS PRIOR TO ANY CONSTRUCTION. ANY JOBSITE CHANGES WILL VOID DESIGNER'S LIABILITY. DESIGNER'S LIABILITY NOT TO EXCEED FEE PAID FOR PLANS.

No.	Description	Date
1	PERMIT SET	08-30-2021

RYAN JACOBSON DESIGN LLC

ACCNET CONSTRUCTION

LEVEL 1 FLOOR PLAN


Project number AC - 1  
 Date 8/30/2021

**A02.01**

Scale 3/16" = 1'-0"

Door Schedule		
Mark	Type	Material
102	60" x 96"	
104A	28" GLASS	GLASS
104B	28" GLASS	GLASS
105	28" x 96"	WOOD
106A	36" x 96"	OPENING
106B	36" x 96"	OPENING
108	16" x 8" Sliding Glass Door	GLASS
109A	36" x 96"	WOOD
109B	18" x 8"	GARAGE
110A	36" x 96"	WOOD
110B	36" x 96"	GLASS
111A	36" x 96"	WOOD
111B	9" x 8"	GARAGE
111C	36" x 96"	WOOD
112A	28" x 96"	WOOD
112B	28" x 96"	WOOD
113	32" x 96"	WOOD
114	28" x 96"	WOOD
115A	16" x 8" Sliding Glass Door	GLASS
115B	16" x 8" Sliding Glass Door	GLASS
117	16" x 8" Sliding Glass Door	GLASS
118	28" x 96"	WOOD
119	28" x 96"	WOOD
120A	48" x 96"	WOOD
120B	60" x 96"	
121	28" x 96"	WOOD
122A	28" x 96"	WOOD
122B	28" x 96"	WOOD
123A	32" x 96"	WOOD
123B	32" x 96"	WOOD
125A	48" x 96"	WOOD
125B	28" x 96"	WOOD
126A	32" x 96"	WOOD
126B	60" x 96"	
126C	60" x 96"	
127A	28" x 96"	WOOD
127B	36" x 96"	OPENING
203A	28" x 96"	WOOD
203B	28" x 96"	WOOD
204	32" x 96"	WOOD
205	28" x 96"	WOOD
207	32" x 96"	WOOD
208	28" x 96"	WOOD
209	28" x 96"	WOOD
211	32" x 96"	WOOD
212	28" x 96"	WOOD
213	28" x 96"	WOOD
301A	46" x 96"	
301B	36" x 96"	GLASS
301C	6'x8' Sliding Glass Door	
301D	6'x8' Sliding Glass Door	
302	32" x 96"	WOOD
303	32" x 96"	WOOD
304A	36" x 96"	WOOD
304B	36" x 96"	GLASS
304C	9' x 9'	
401A	28" x 96"	WOOD
402A	28" x 96"	WOOD
403	28" x 96"	WOOD

Window Schedule			
Mark	Type	Sill Height	Head Height
102A	3 Panel 36"x96"	0"	8' - 0"
102B	3 Panel 24"x96"	0"	8' - 0"
102C	3 Panel 24"x96"	0"	8' - 0"
103A	3 Panel 36"x96"	0"	8' - 0"
103B	3 Panel 36"x96"	0"	8' - 0"
103C	3 Panel 36"x96"	0"	8' - 0"
103D	3 Panel 36"x96"	0"	8' - 0"
103E	3 Panel 36"x96"	0"	8' - 0"
103F	3 Panel 36"x96"	0"	8' - 0"
107A	3 Panel 36"x72" S.H.	2' - 0"	8' - 0"
107B	3 Panel 36"x72" S.H.	2' - 0"	8' - 0"
114E	72" x 12"	7' - 0"	8' - 0"
119	3 Panel 36"x96"	0"	8' - 0"
122	48" x 12" BLACK	7' - 0"	8' - 0"
124	3 Panel 36"x72" S.H.	2' - 0"	8' - 0"
201A	3 Panel 36"x72" S.H.	2' - 0"	8' - 0"
201B	3 Panel 36"x72" S.H.	2' - 0"	8' - 0"
201C	3 Panel 36"x72" S.H.	2' - 0"	8' - 0"
202A	3 Panel 36"x96"	0"	8' - 0"
202B	3 Panel 36"x96"	0"	8' - 0"
202C	3 Panel 36"x96"	0"	8' - 0"
202D	3 Panel 36"x96"	0"	8' - 0"
202E	3 Panel 36"x96"	0"	8' - 0"
202F	3 Panel 36"x96"	0"	8' - 0"
204	3 Panel 36"x72" S.H.	2' - 0"	8' - 0"
207	3 Panel 36"x72" S.H.	2' - 0"	8' - 0"
210A	60" x 24"	7' - 0"	9' - 0"
210B	60" x 24"	7' - 0"	9' - 0"
210C	60" x 24"	7' - 0"	9' - 0"
210D	60" x 24"	7' - 0"	9' - 0"
402A	48" x 12" BLACK	7' - 0"	8' - 0"
402B	48" x 12" BLACK	7' - 0"	8' - 0"
402C	48" x 12" BLACK	7' - 0"	8' - 0"

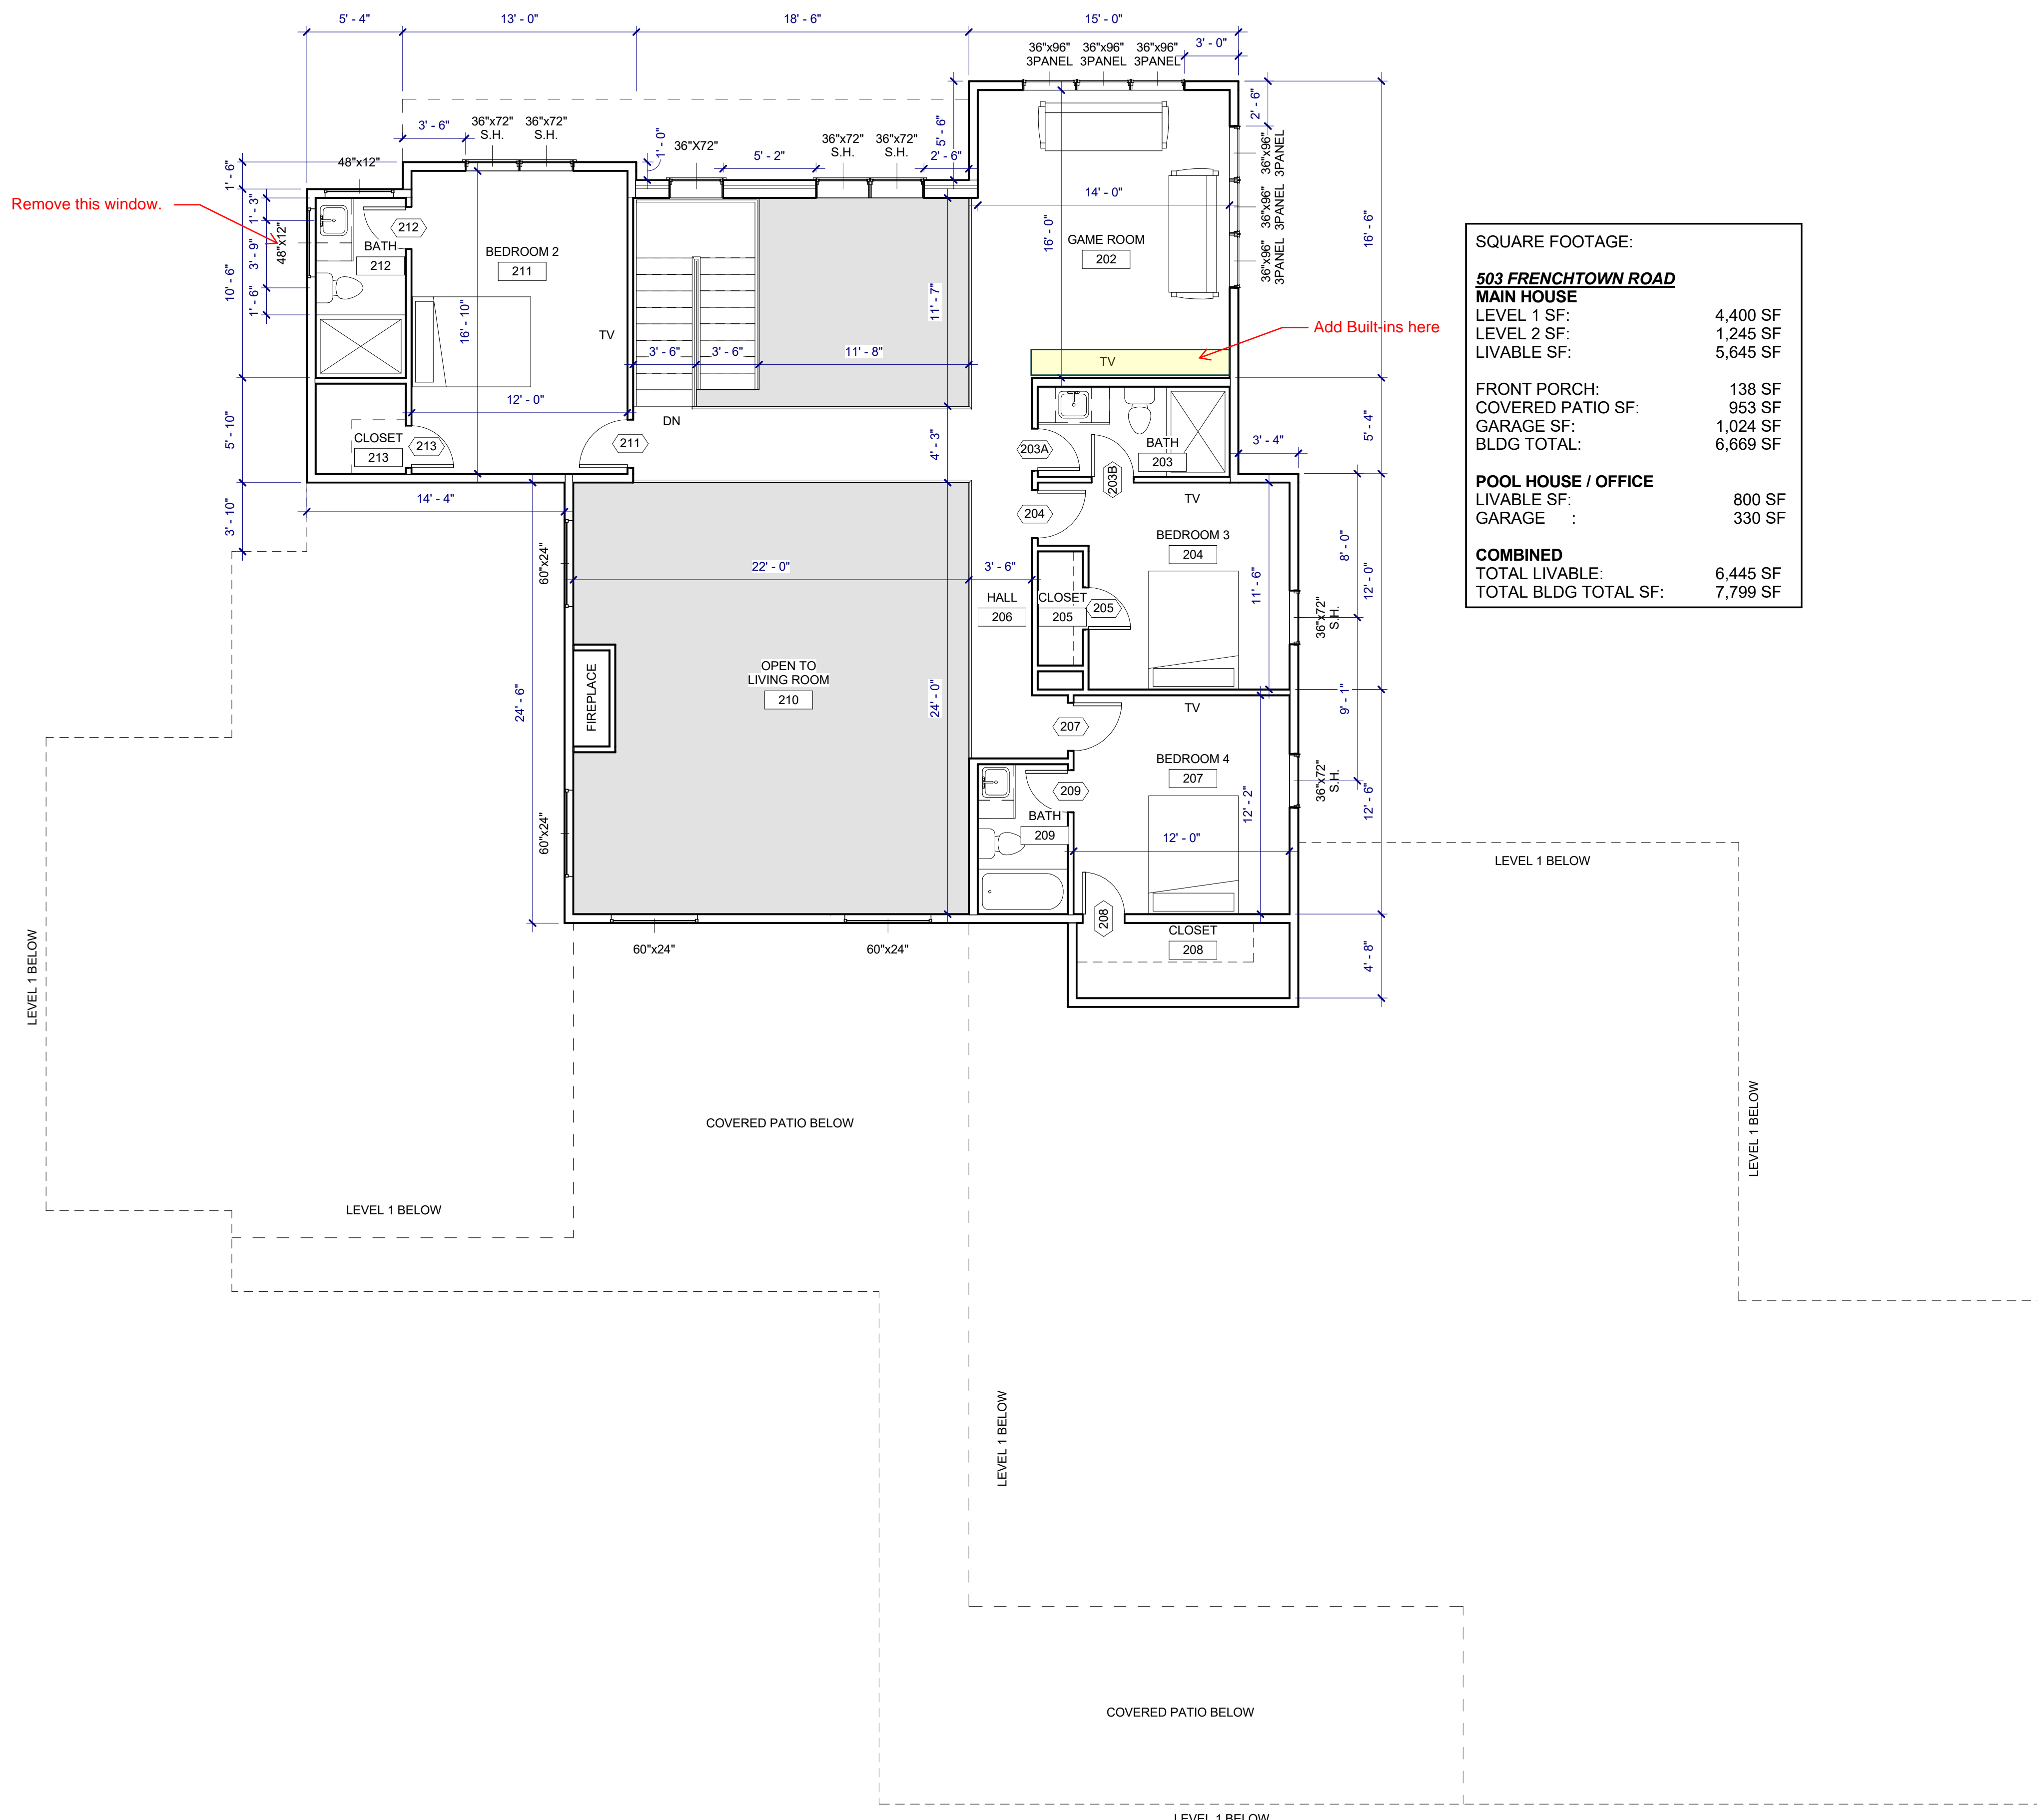

**SQUARE FOOTAGE:**

**503 FRENCHTOWN ROAD**

**MAIN HOUSE**

LEVEL 1 SF: 4,400 SF

LEVEL 2 SF: 1,245 SF

LIVABLE SF: 5,645 SF

**FRONT PORCH:** 138 SF

**COVERED PATIO SF:** 953 SF

**GARAGE SF:** 1,024 SF

**BLDG TOTAL:** 6,669 SF

**POOL HOUSE / OFFICE**

LIVABLE SF: 800 SF

GARAGE : 330 SF

**COMBINED**

TOTAL LIVABLE: 6,445 SF

TOTAL BLDG TOTAL SF: 7,799 SF

503 FRENCHTOWN ROAD  
ARGYLE, TX 76226

THESE PLANS ARE THE PROPERTY OF RYAN JACOBSON DESIGN LLC AND ARE NOT TO BE REPRODUCED, TRACED, OR REUSED FOR CONSTRUCTION WITHOUT THE WRITTEN PERMISSION OF RYAN JACOBSON DESIGN LLC. THESE PLANS ARE INTENDED TO PROVIDE ALL PROSPECTIVE CONTRACTORS, AND/OR BUILDING MANUFACTURERS THE NECESSARY INFORMATION NEEDED TO DESIGN, BID, AND CONSTRUCT THIS BUILDING. OWNER SHALL VERIFY AND CHECK ALL ASPECTS PRIOR TO ANY CONSTRUCTION. ANY JOBSITE CHANGES WILL VOID DESIGNER'S LIABILITY. DESIGNER'S LIABILITY NOT TO EXCEED FEE PAID FOR PLANS.

No.	Description	Date
1	PERMIT SET	08-30-2021

RYAN JACOBSON DESIGN LLC

ACCNET CONSTRUCTION


LEVEL 2 FLOOR PLAN

Project number AC - 1  
Date 8/30/2021


**A02.02**

Scale 3/16" = 1'-0"


**LEVEL 2 FLOOR PLAN**  
SCALE: 3/16" = 1'-0"

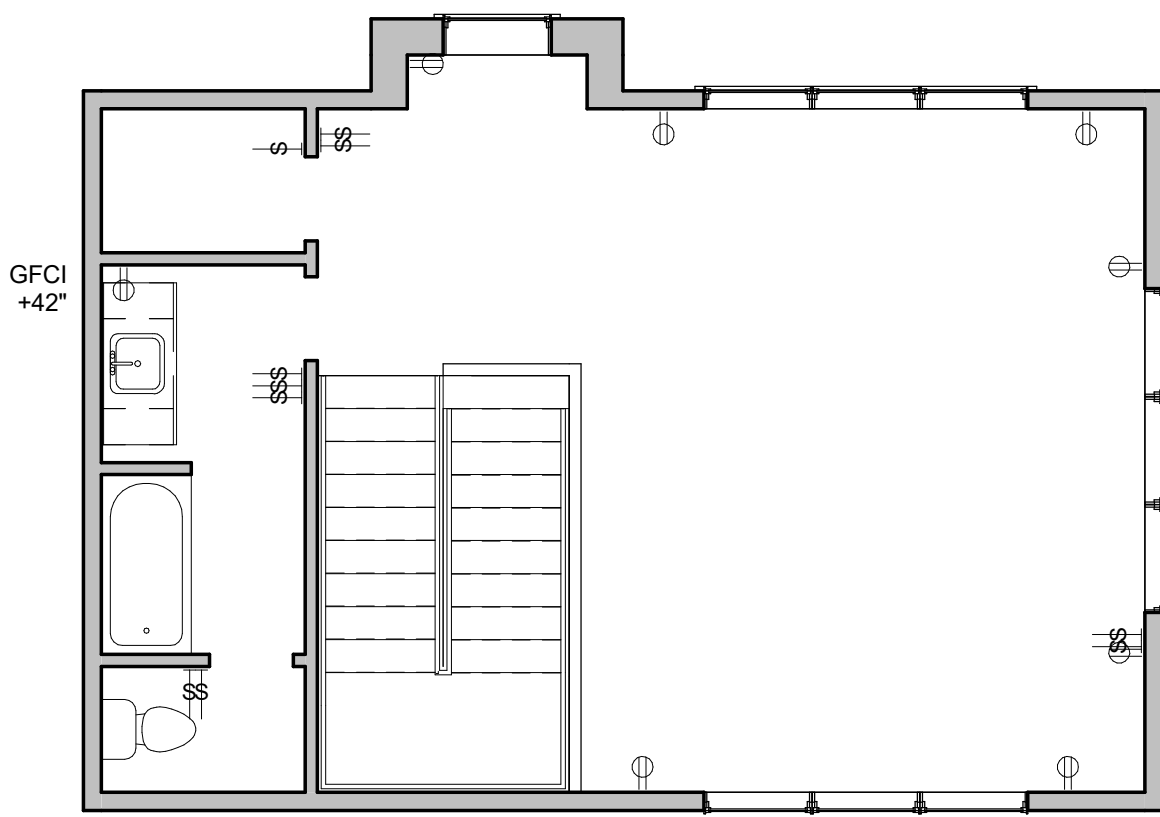


**LEVEL 02 - POWER**  
SCALE: 3/16" = 1'-0" **12**

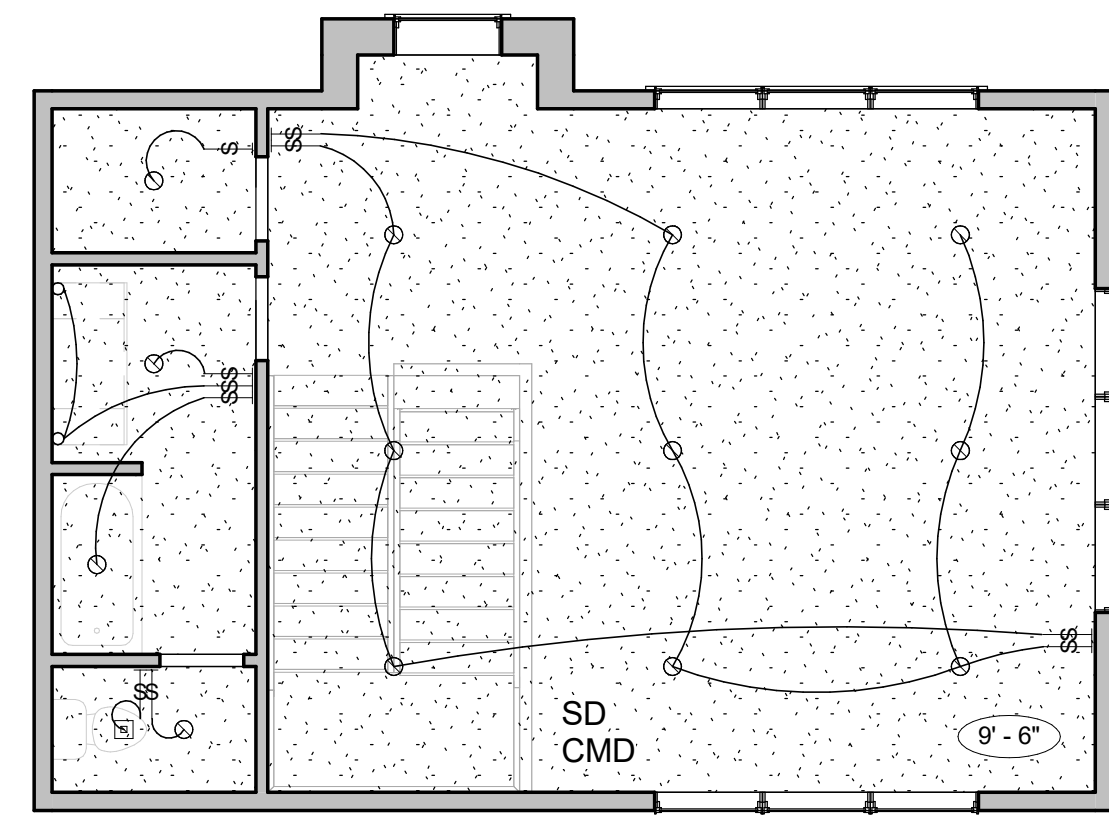


**LEVEL 2 REFLECTED CEILING PLAN**  
SCALE: 3/16" = 1'-0" **10**

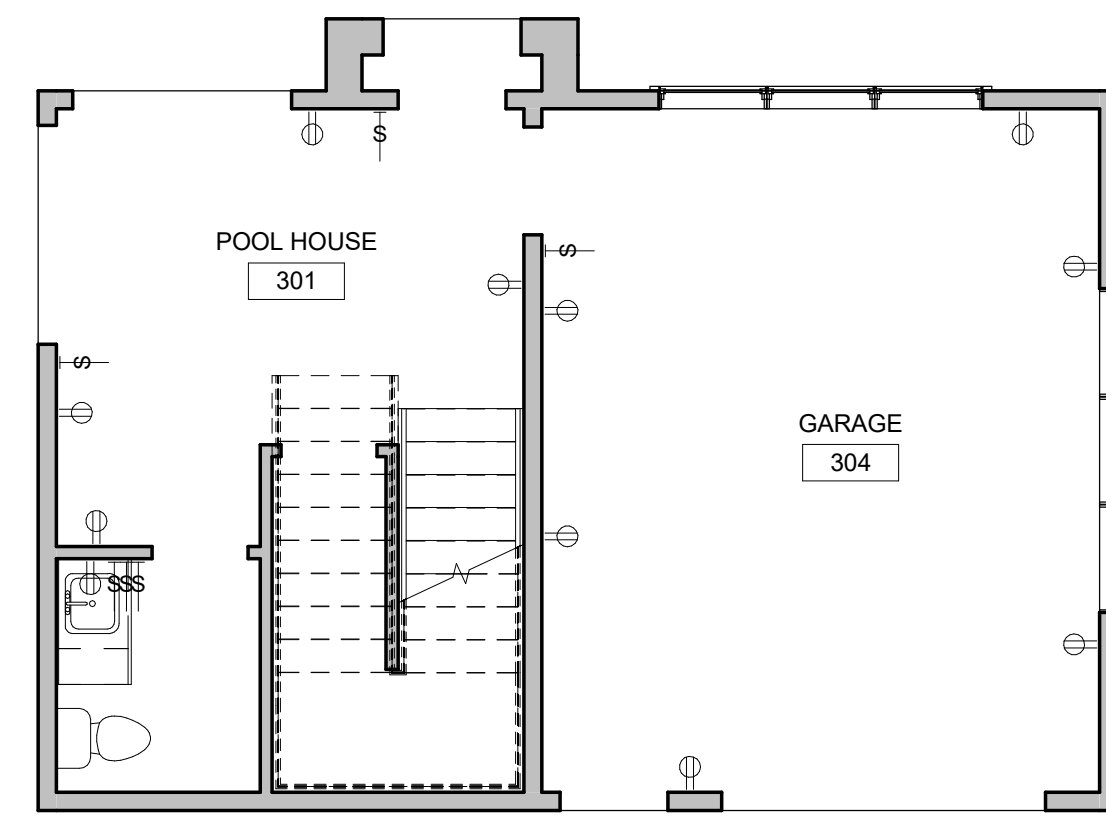


**GUEST HOUSE LEVEL 1 POWER PLAN**  
SCALE: 3/16" = 1'-0" **8**

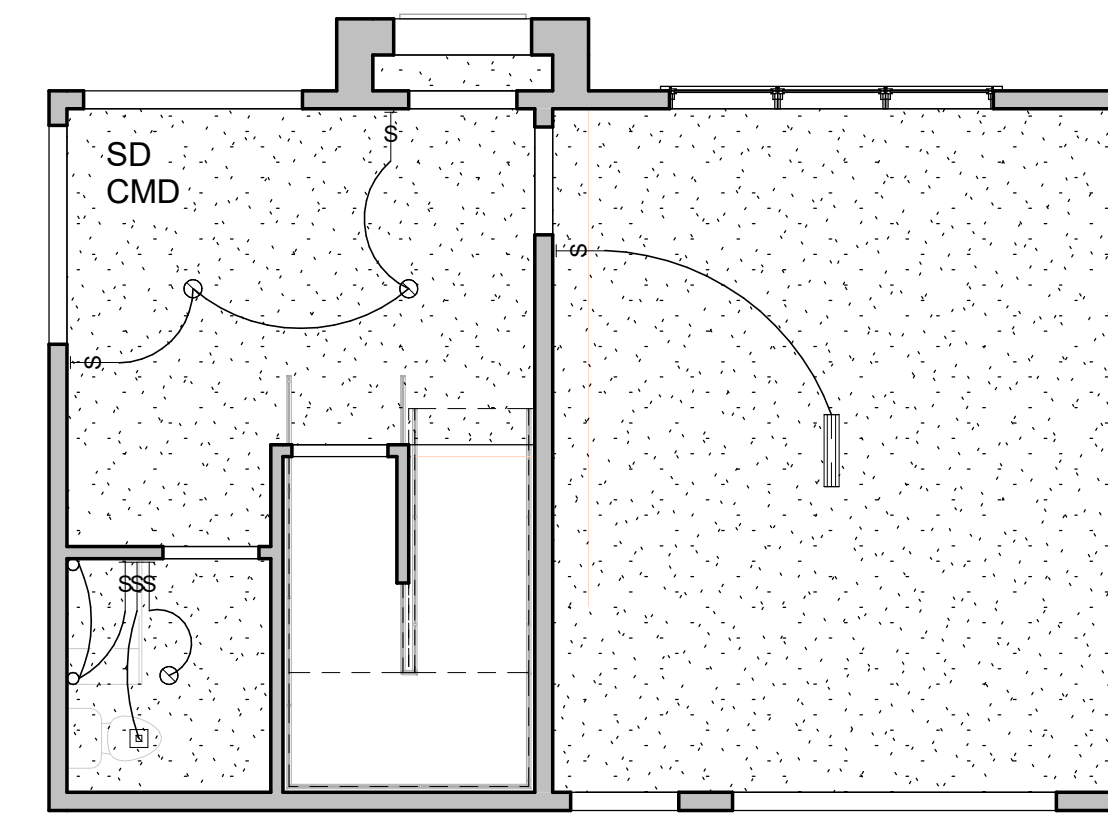


**GUEST HOUSE LEVEL 1 RCP**  
SCALE: 3/16" = 1'-0" **6**

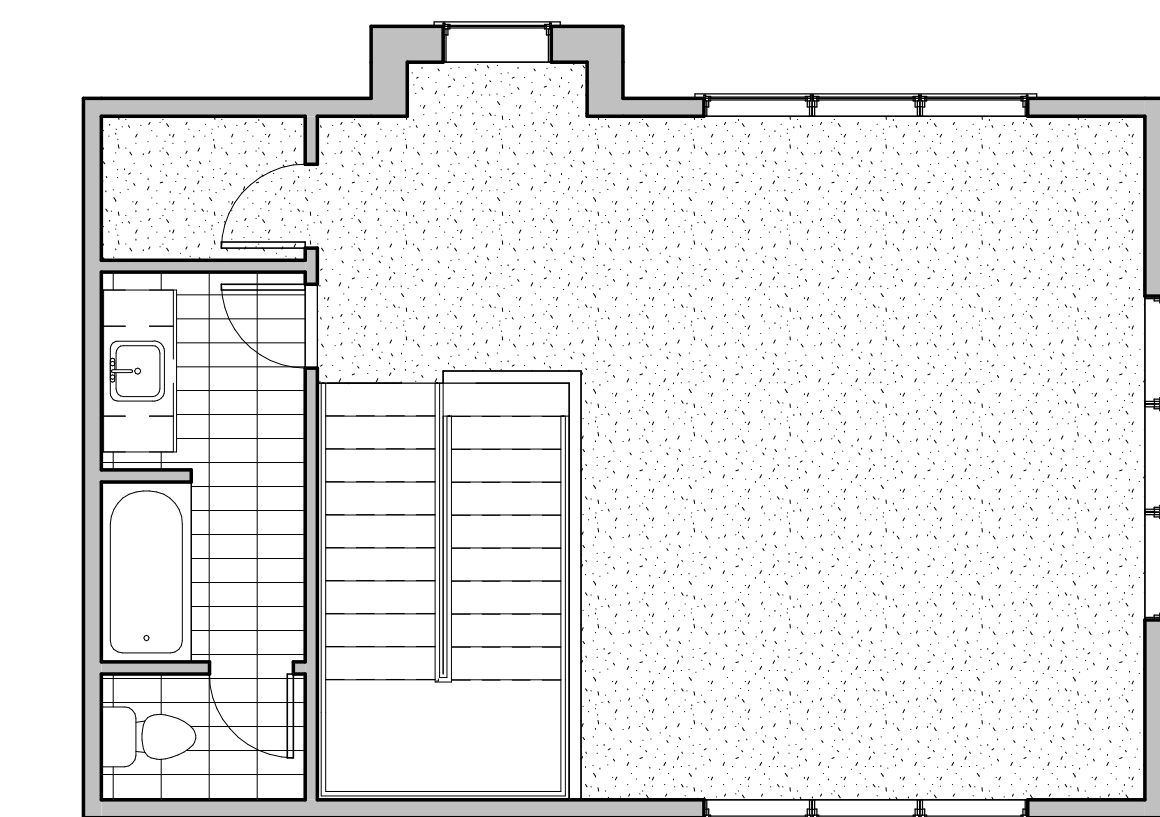


**GUEST HOUSE LEVEL 2 FINISH PLAN**  
SCALE: 3/16" = 1'-0" **11**

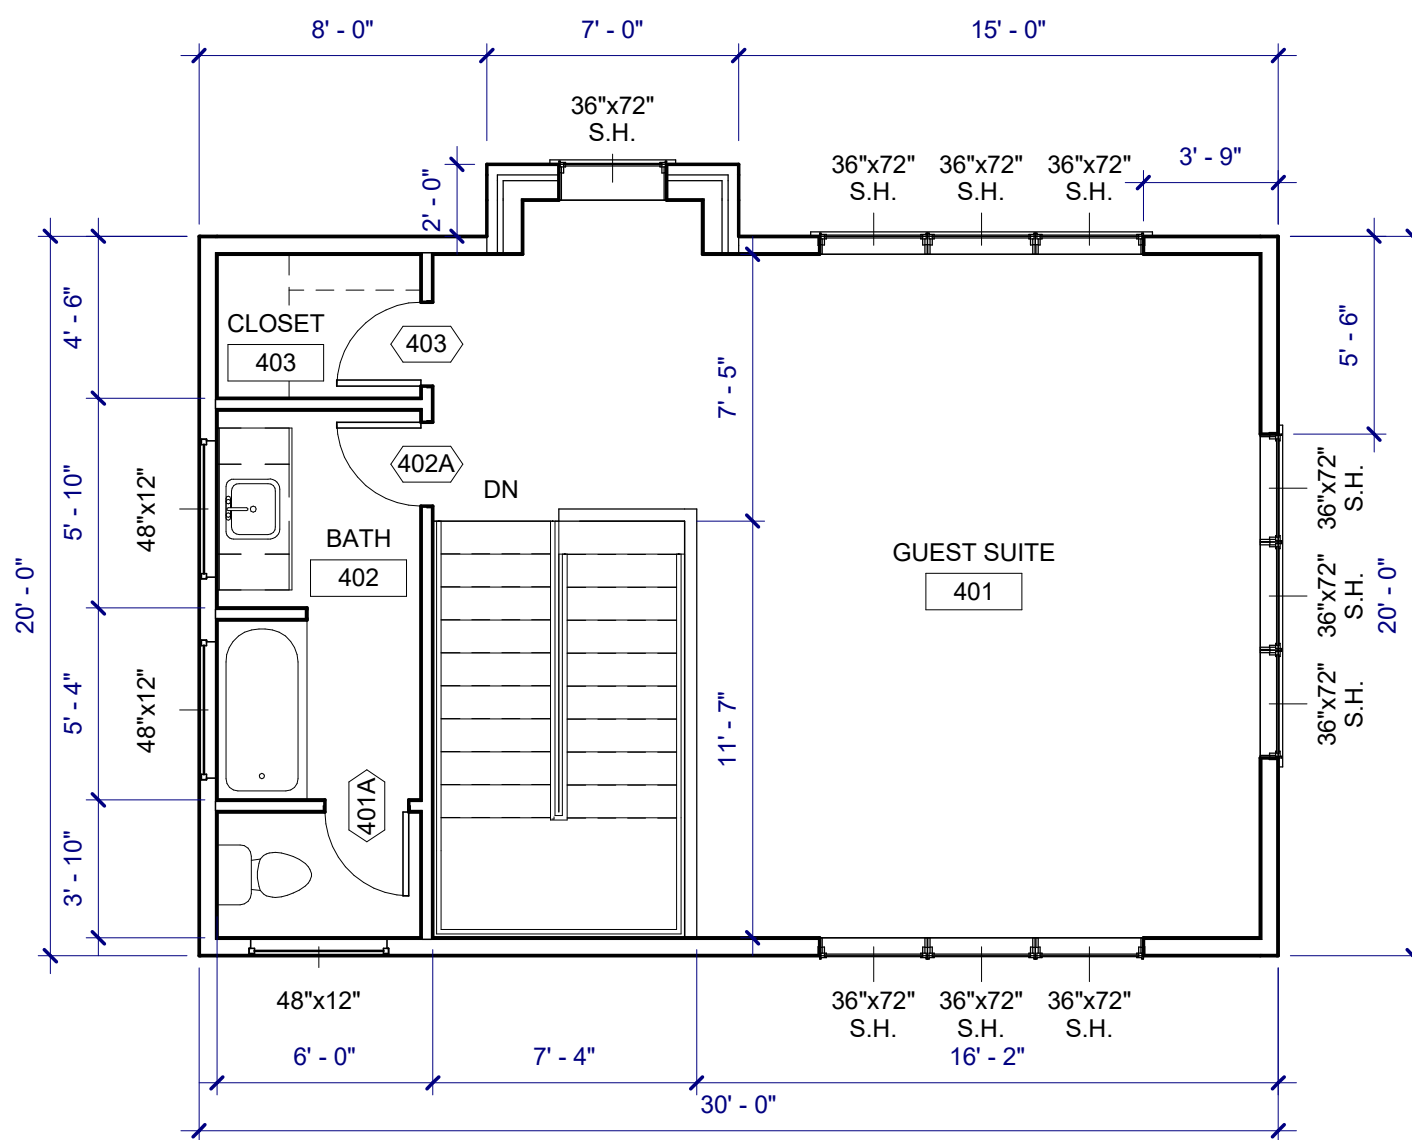


**GUEST HOUSE LEVEL 2 FLOOR PLAN**  
SCALE: 3/16" = 1'-0" **9**

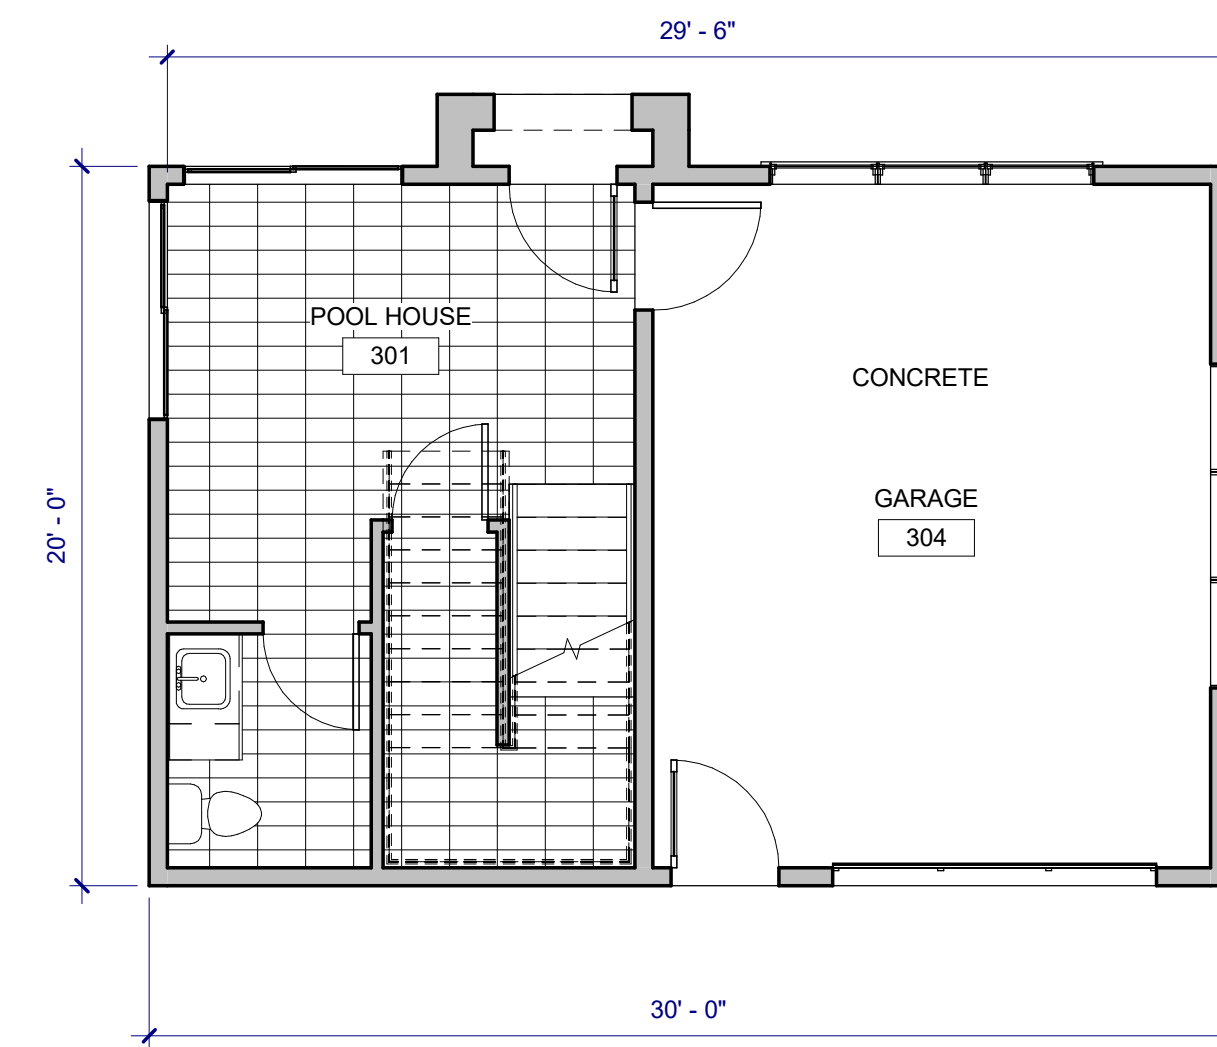

**GUEST HOUSE LEVEL 1 FINISH PLAN**  
SCALE: 3/16" = 1'-0" **7**

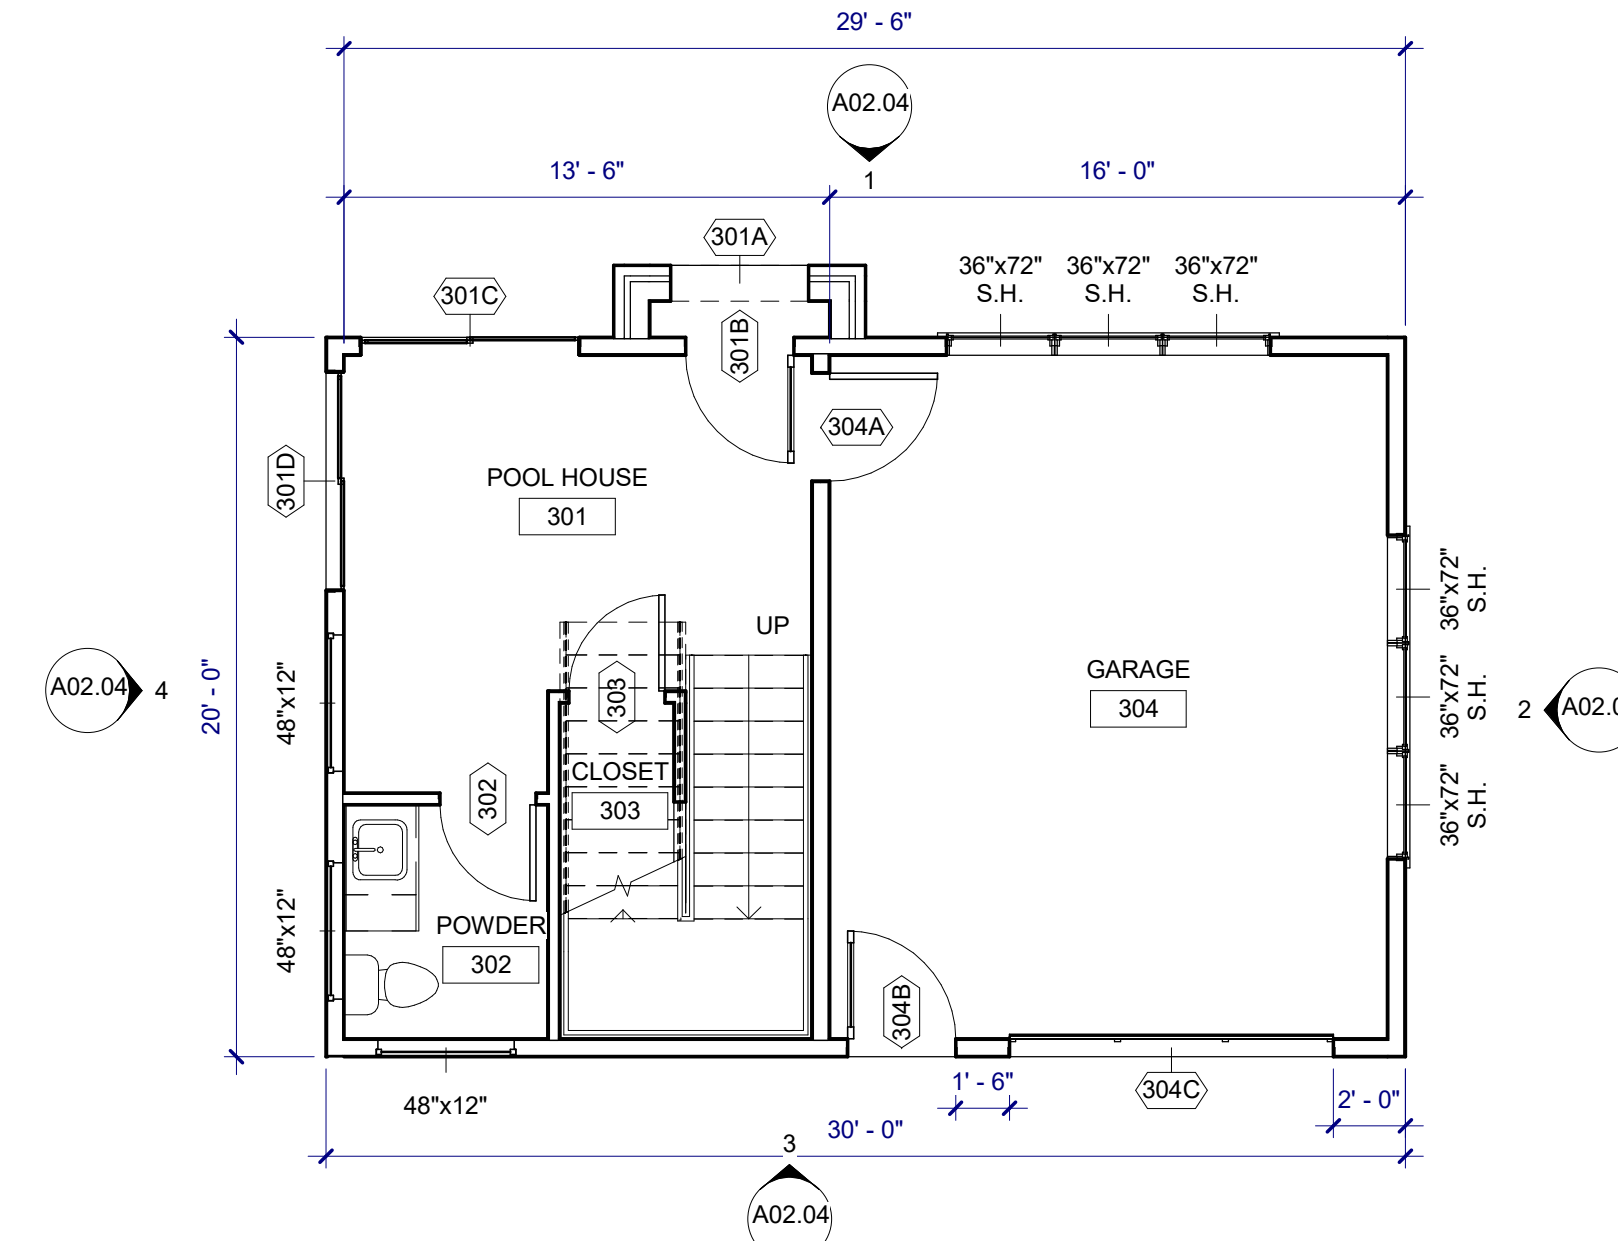

**GUEST HOUSE LEVEL 1 FLOOR PLAN**  
SCALE: 3/16" = 1'-0" **5**

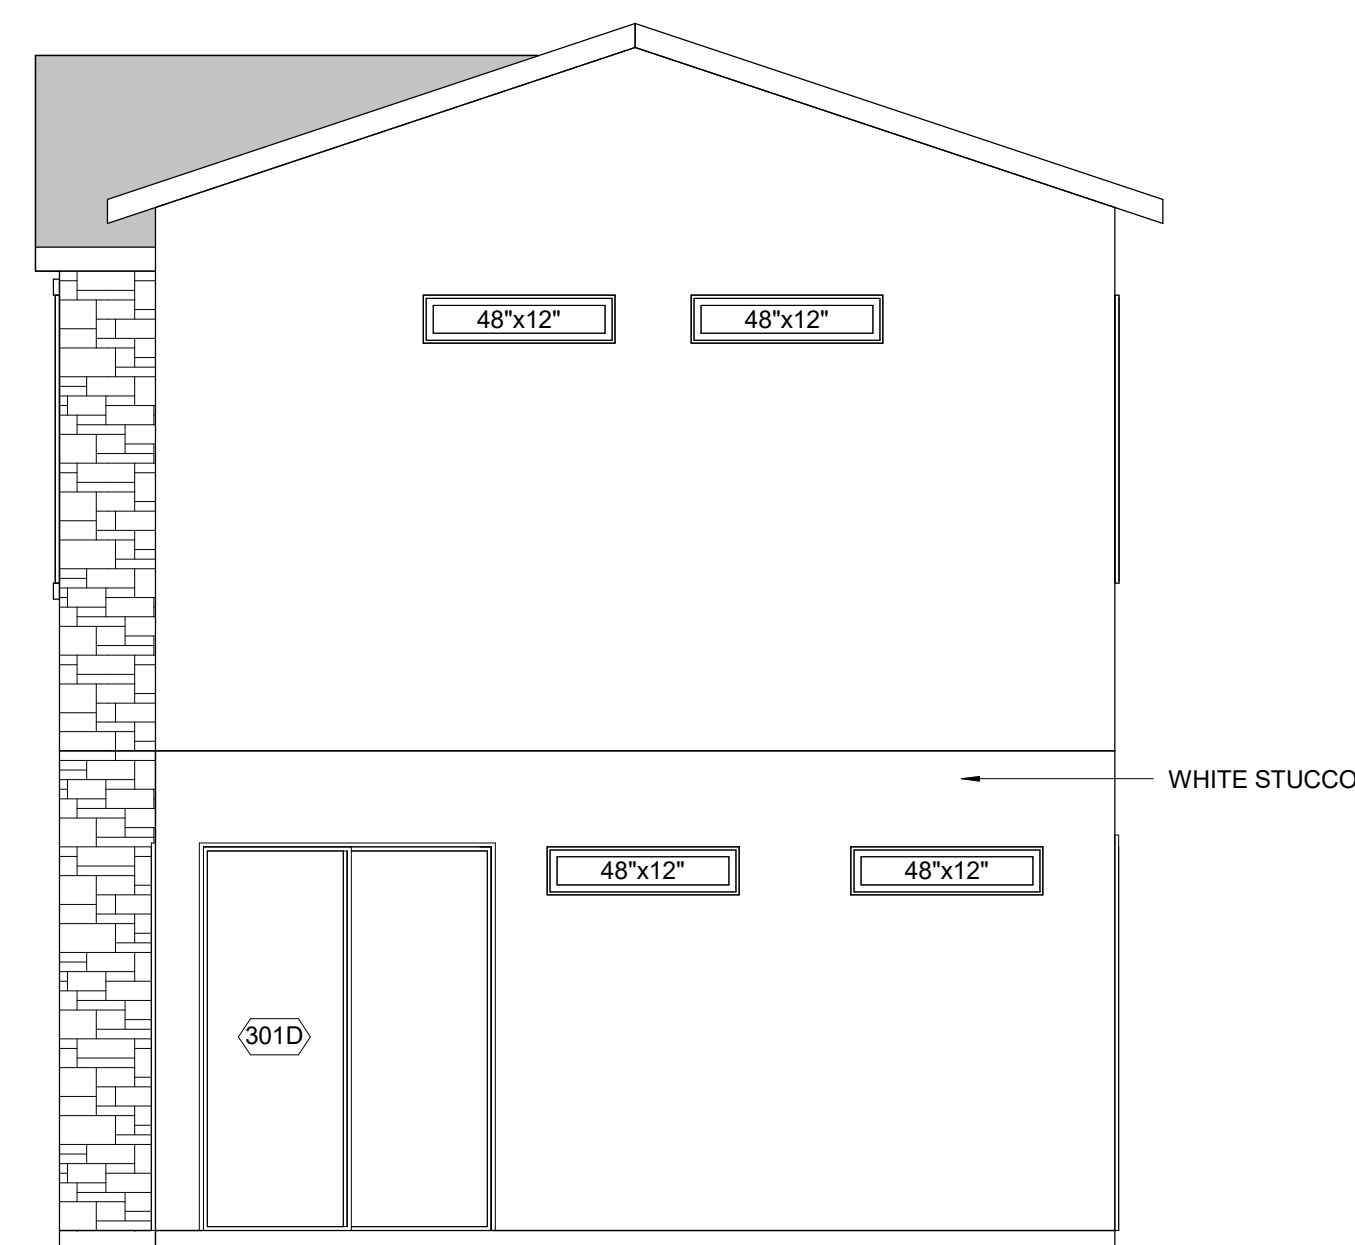

**ELEVATION**  
SCALE: 1/4" = 1'-0" **4**



**ELEVATION**  
SCALE: 1/4" = 1'-0" **3**



**ELEVATION**  
SCALE: 1/4" = 1'-0" **2**



**ELEVATION**  
SCALE: 1/4" = 1'-0" **1**

503 FRENCHTOWN ROAD  
ARGYLE, TX 76226

THESE PLANS ARE THE PROPERTY OF RYAN JACOBSON DESIGN LLC AND ARE NOT TO BE REPRODUCED, TRACED, OR REUSED FOR CONSTRUCTION WITHOUT THE WRITTEN PERMISSION OF RYAN JACOBSON DESIGN LLC. THESE PLANS ARE INTENDED TO PROVIDE ALL PROSPECTIVE CONTRACTORS, AND/OR BUILDING MANUFACTURERS THE NECESSARY INFORMATION NEEDED TO DESIGN, BID, AND CONSTRUCT THIS BUILDING. OWNER SHALL VERIFY AND CHECK ALL ASPECTS PRIOR TO ANY CONSTRUCTION. ANY JOBSITE CHANGES WILL VOID DESIGNER'S LIABILITY. DESIGNER'S LIABILITY NOT TO EXCEED FEE PAID FOR PLANS.

No.	Description	Date
1	PERMIT SET	08-30-2021

RYAN JACOBSON DESIGN LLC

ACCNET CONSTRUCTION

GUEST HOUSE

Project number AC - 1  
Date 8/30/2021


**A02.04**

Scale As indicated

**LEGEND**

SD = SMOKE DETECTOR  
 CMD = CARBON MONOXIDE DETECTOR


Add Millwork ceiling beams in here.  
 Rework lighting layout.

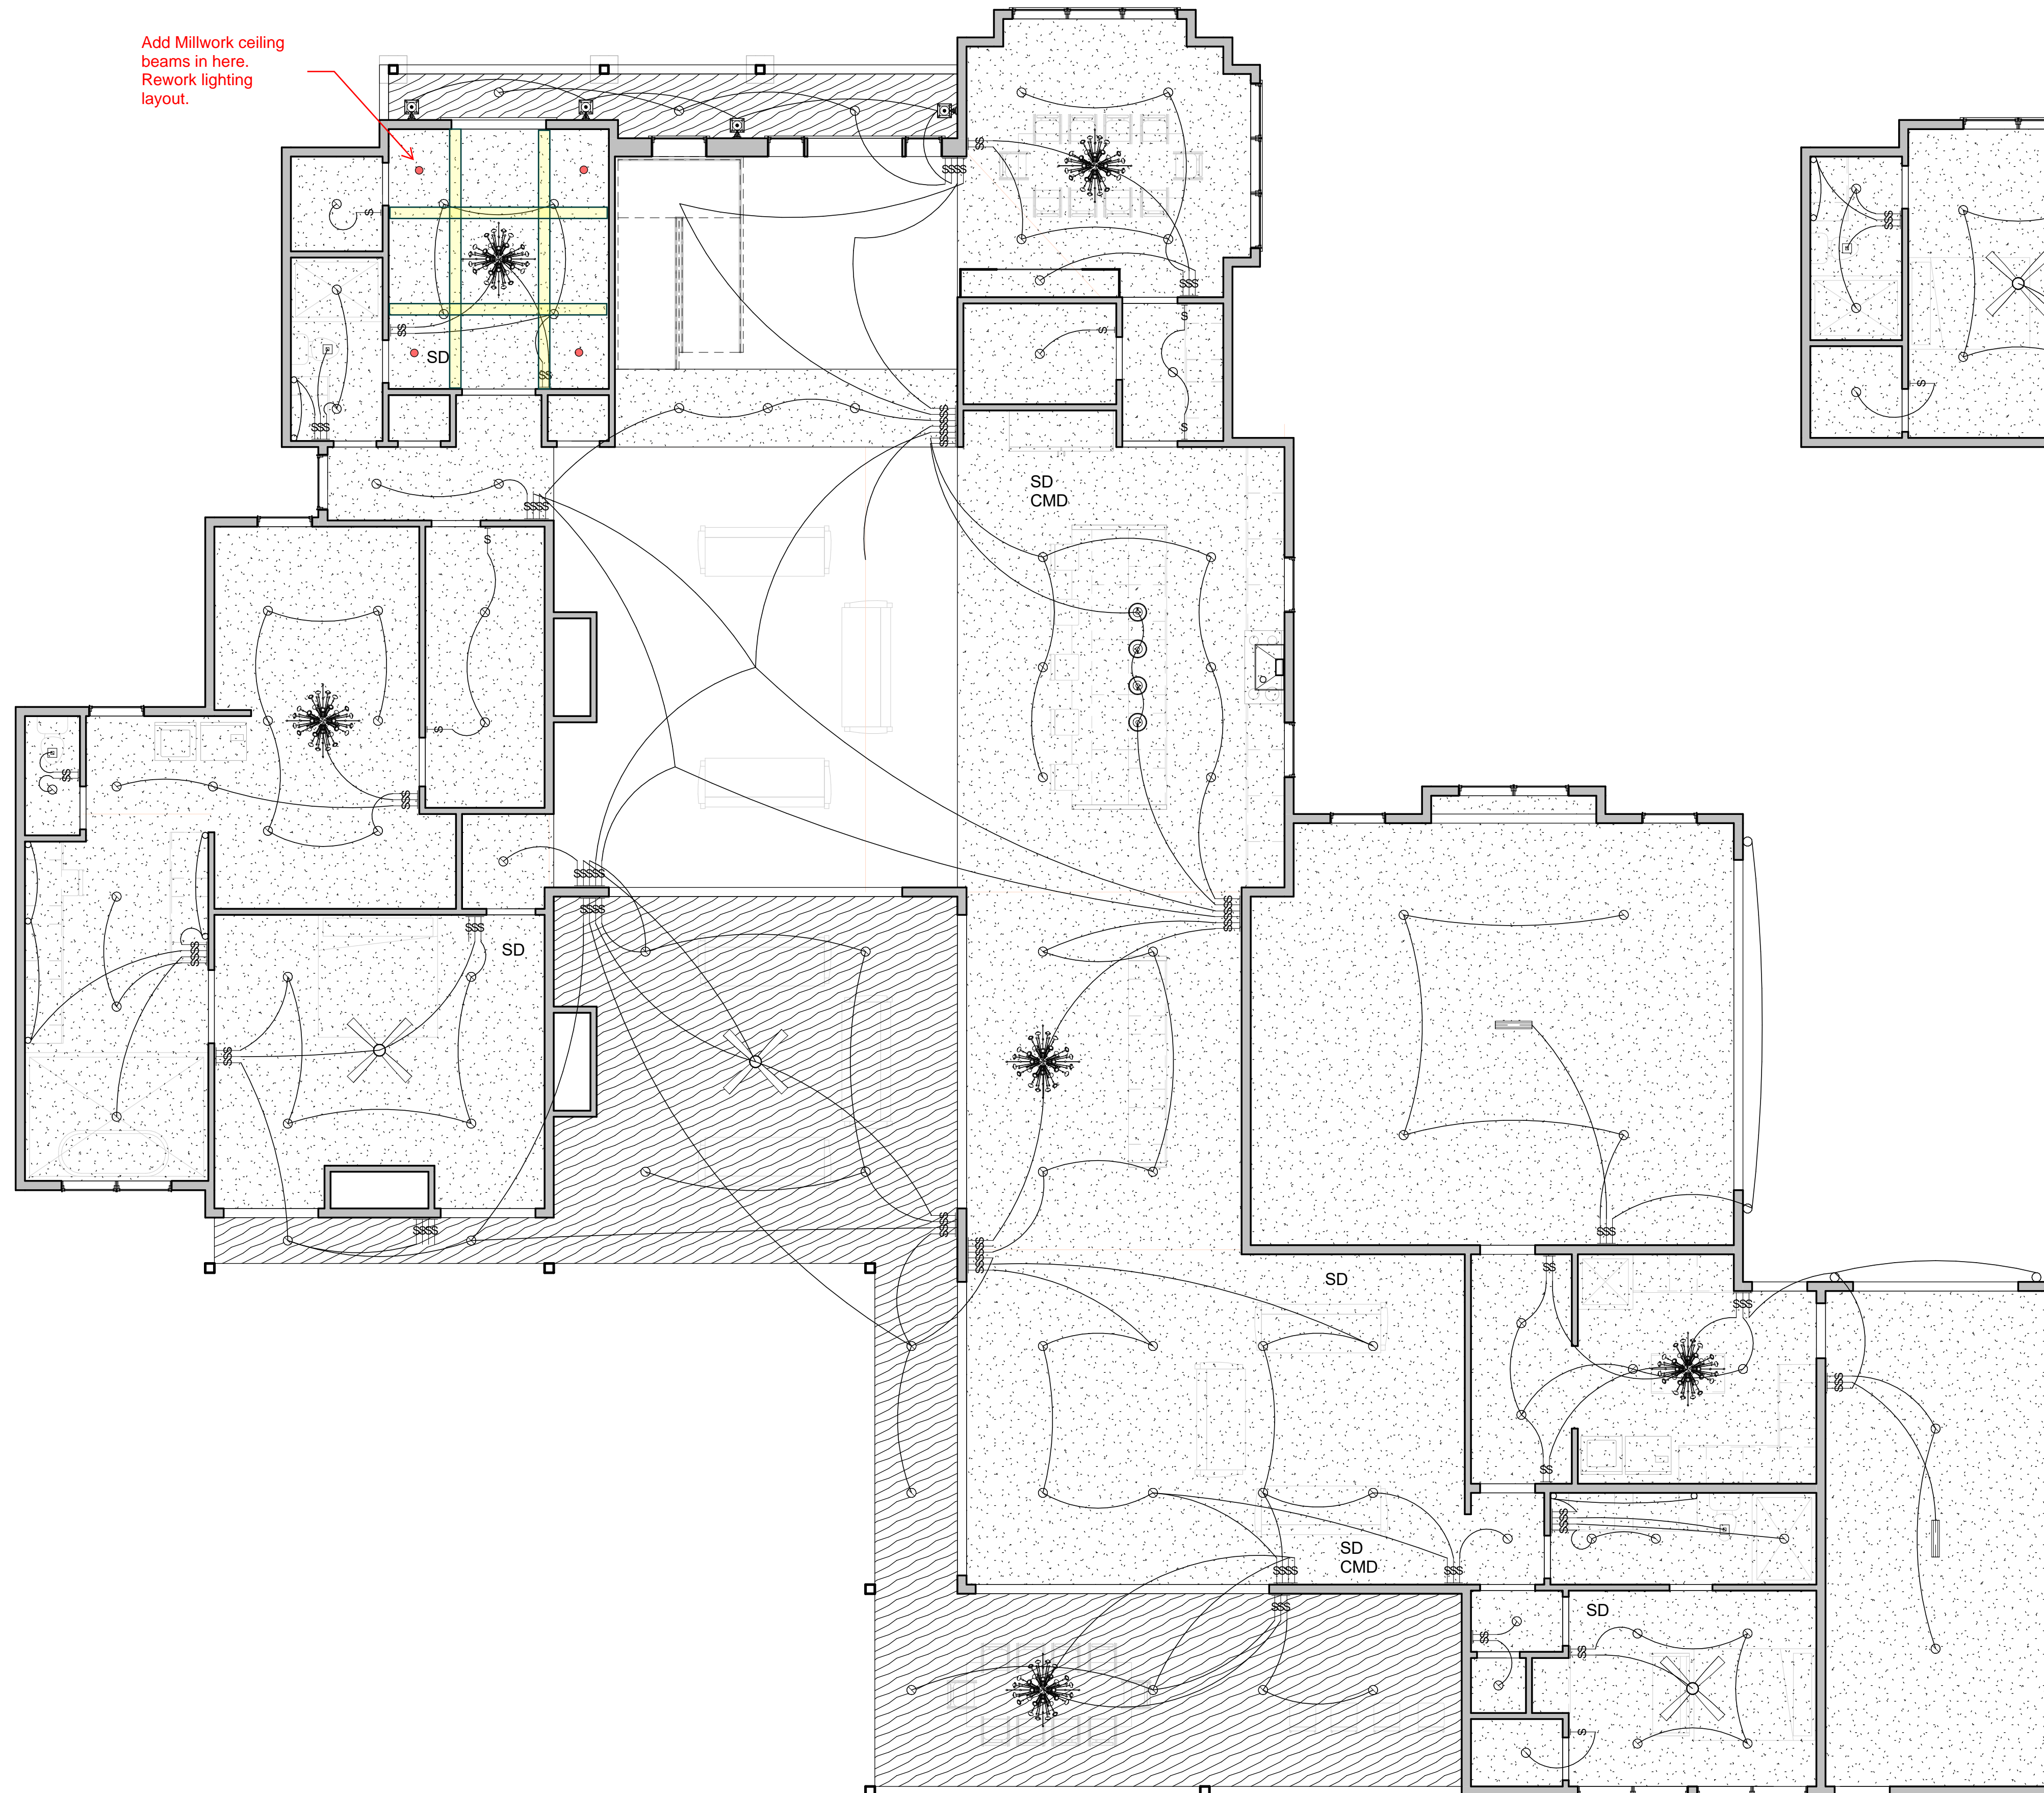

**LEVEL 01 REFLECTED CEILING PLAN**

SCALE: 3/16" = 1'-0"

**1**

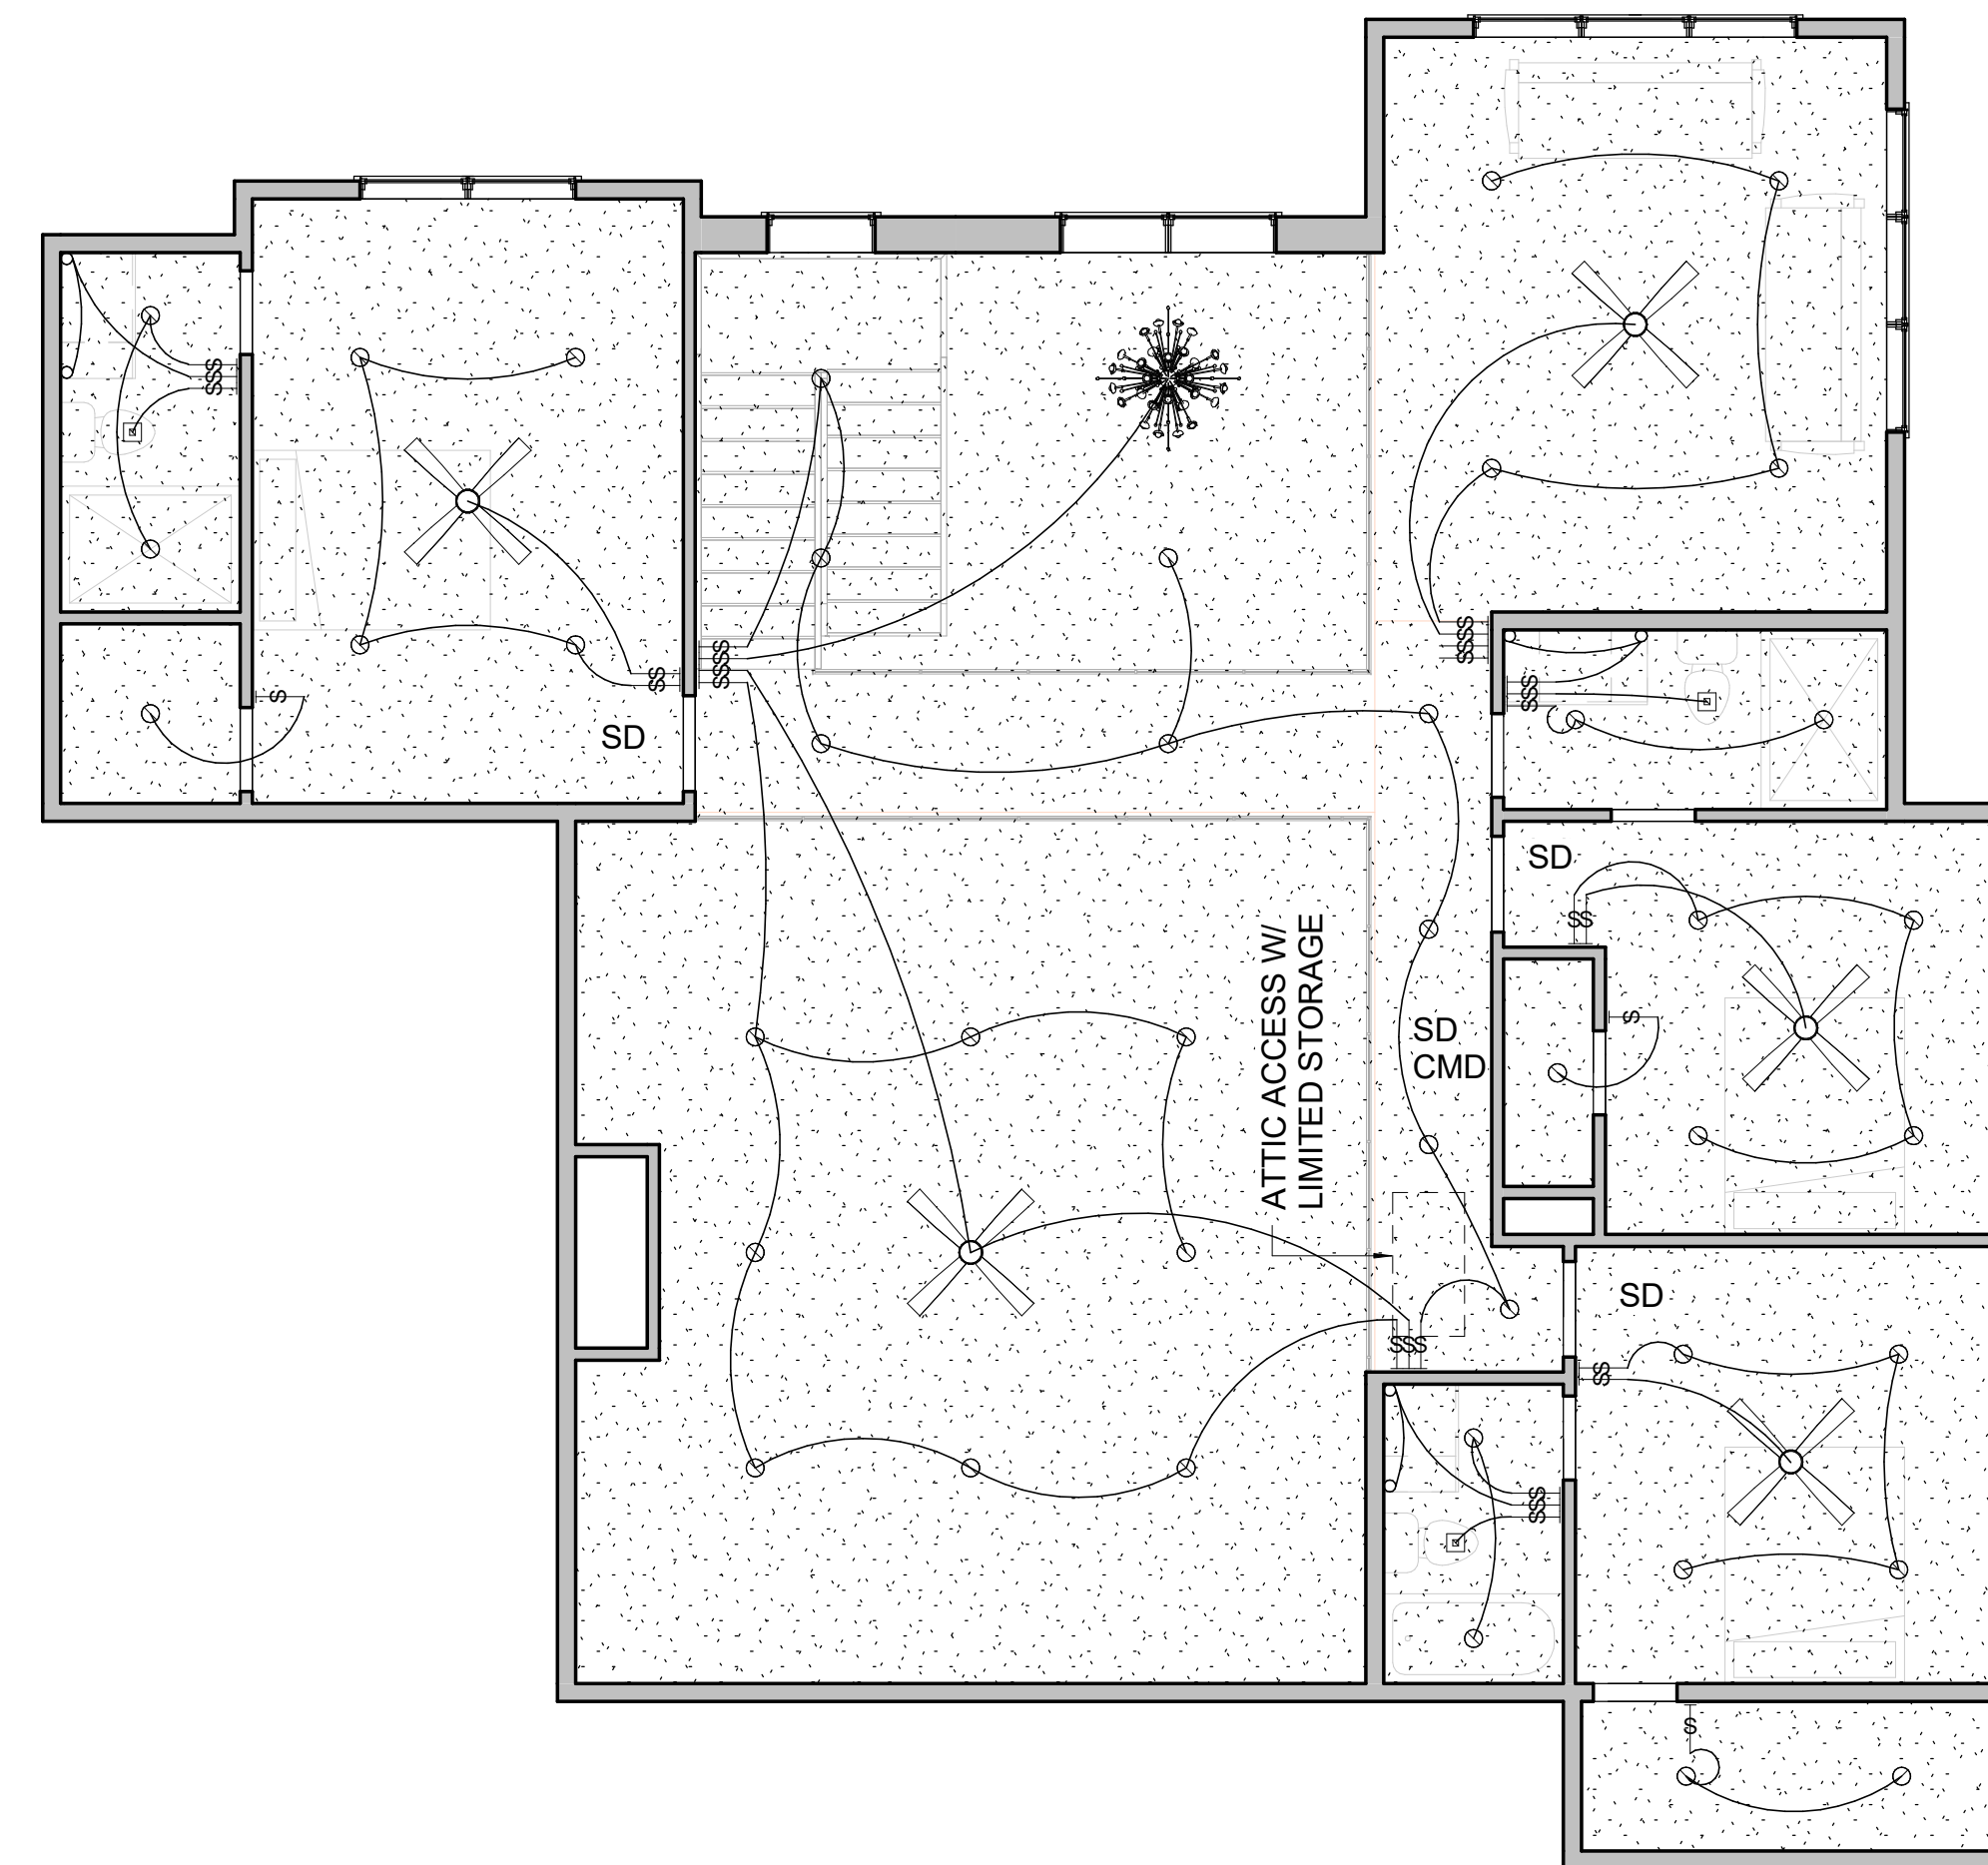

**LEVEL 2 REFLECTED CEILING PLAN**

SCALE: 3/16" = 1'-0"

**2**

503 FRENCHTOWN ROAD  
 ARGYLE, TX 76226

THESE PLANS ARE THE PROPERTY OF RYAN JACOBSON DESIGN LLC AND ARE NOT TO BE REPRODUCED, TRACED, OR REUSED FOR CONSTRUCTION WITHOUT THE WRITTEN PERMISSION OF RYAN JACOBSON DESIGN LLC. THESE PLANS ARE INTENDED TO PROVIDE ALL PROSPECTIVE CONTRACTORS, AND/OR BUILDING MANUFACTURERS THE NECESSARY INFORMATION NEEDED TO DESIGN, BID, AND CONSTRUCT THIS BUILDING. OWNER SHALL VERIFY AND CHECK ALL ASPECTS PRIOR TO ANY CONSTRUCTION. ANY JOBSITE CHANGES WILL VOID DESIGNER'S LIABILITY. DESIGNER'S LIABILITY NOT TO EXCEED FEE PAID FOR PLANS.

No.	Description	Date
1	PERMIT SET	08-30-2021

RYAN JACOBSON DESIGN LLC

ACCNET CONSTRUCTION

LEVEL 1 REFLECTED CEILING PLAN

Project number AC - 1  
 Date 8/30/2021

**A04.01**


Scale 3/16" = 1'-0"

WF-1 = 3,166 SF  
 TL-01 = 740 SF  
 TL-02 = 104 SF

WF-1 = 390 SF  
 TL-01 = 99 SF  
 TL-02 = 33 SF  
 CPT-1 = 580 SF

INSET PATTERN  
 (TBD) IN FLOOR  
 CENTERED ON  
 ENTRY DOORS

CHANGE MASTER CLOSET  
 TO CARPET

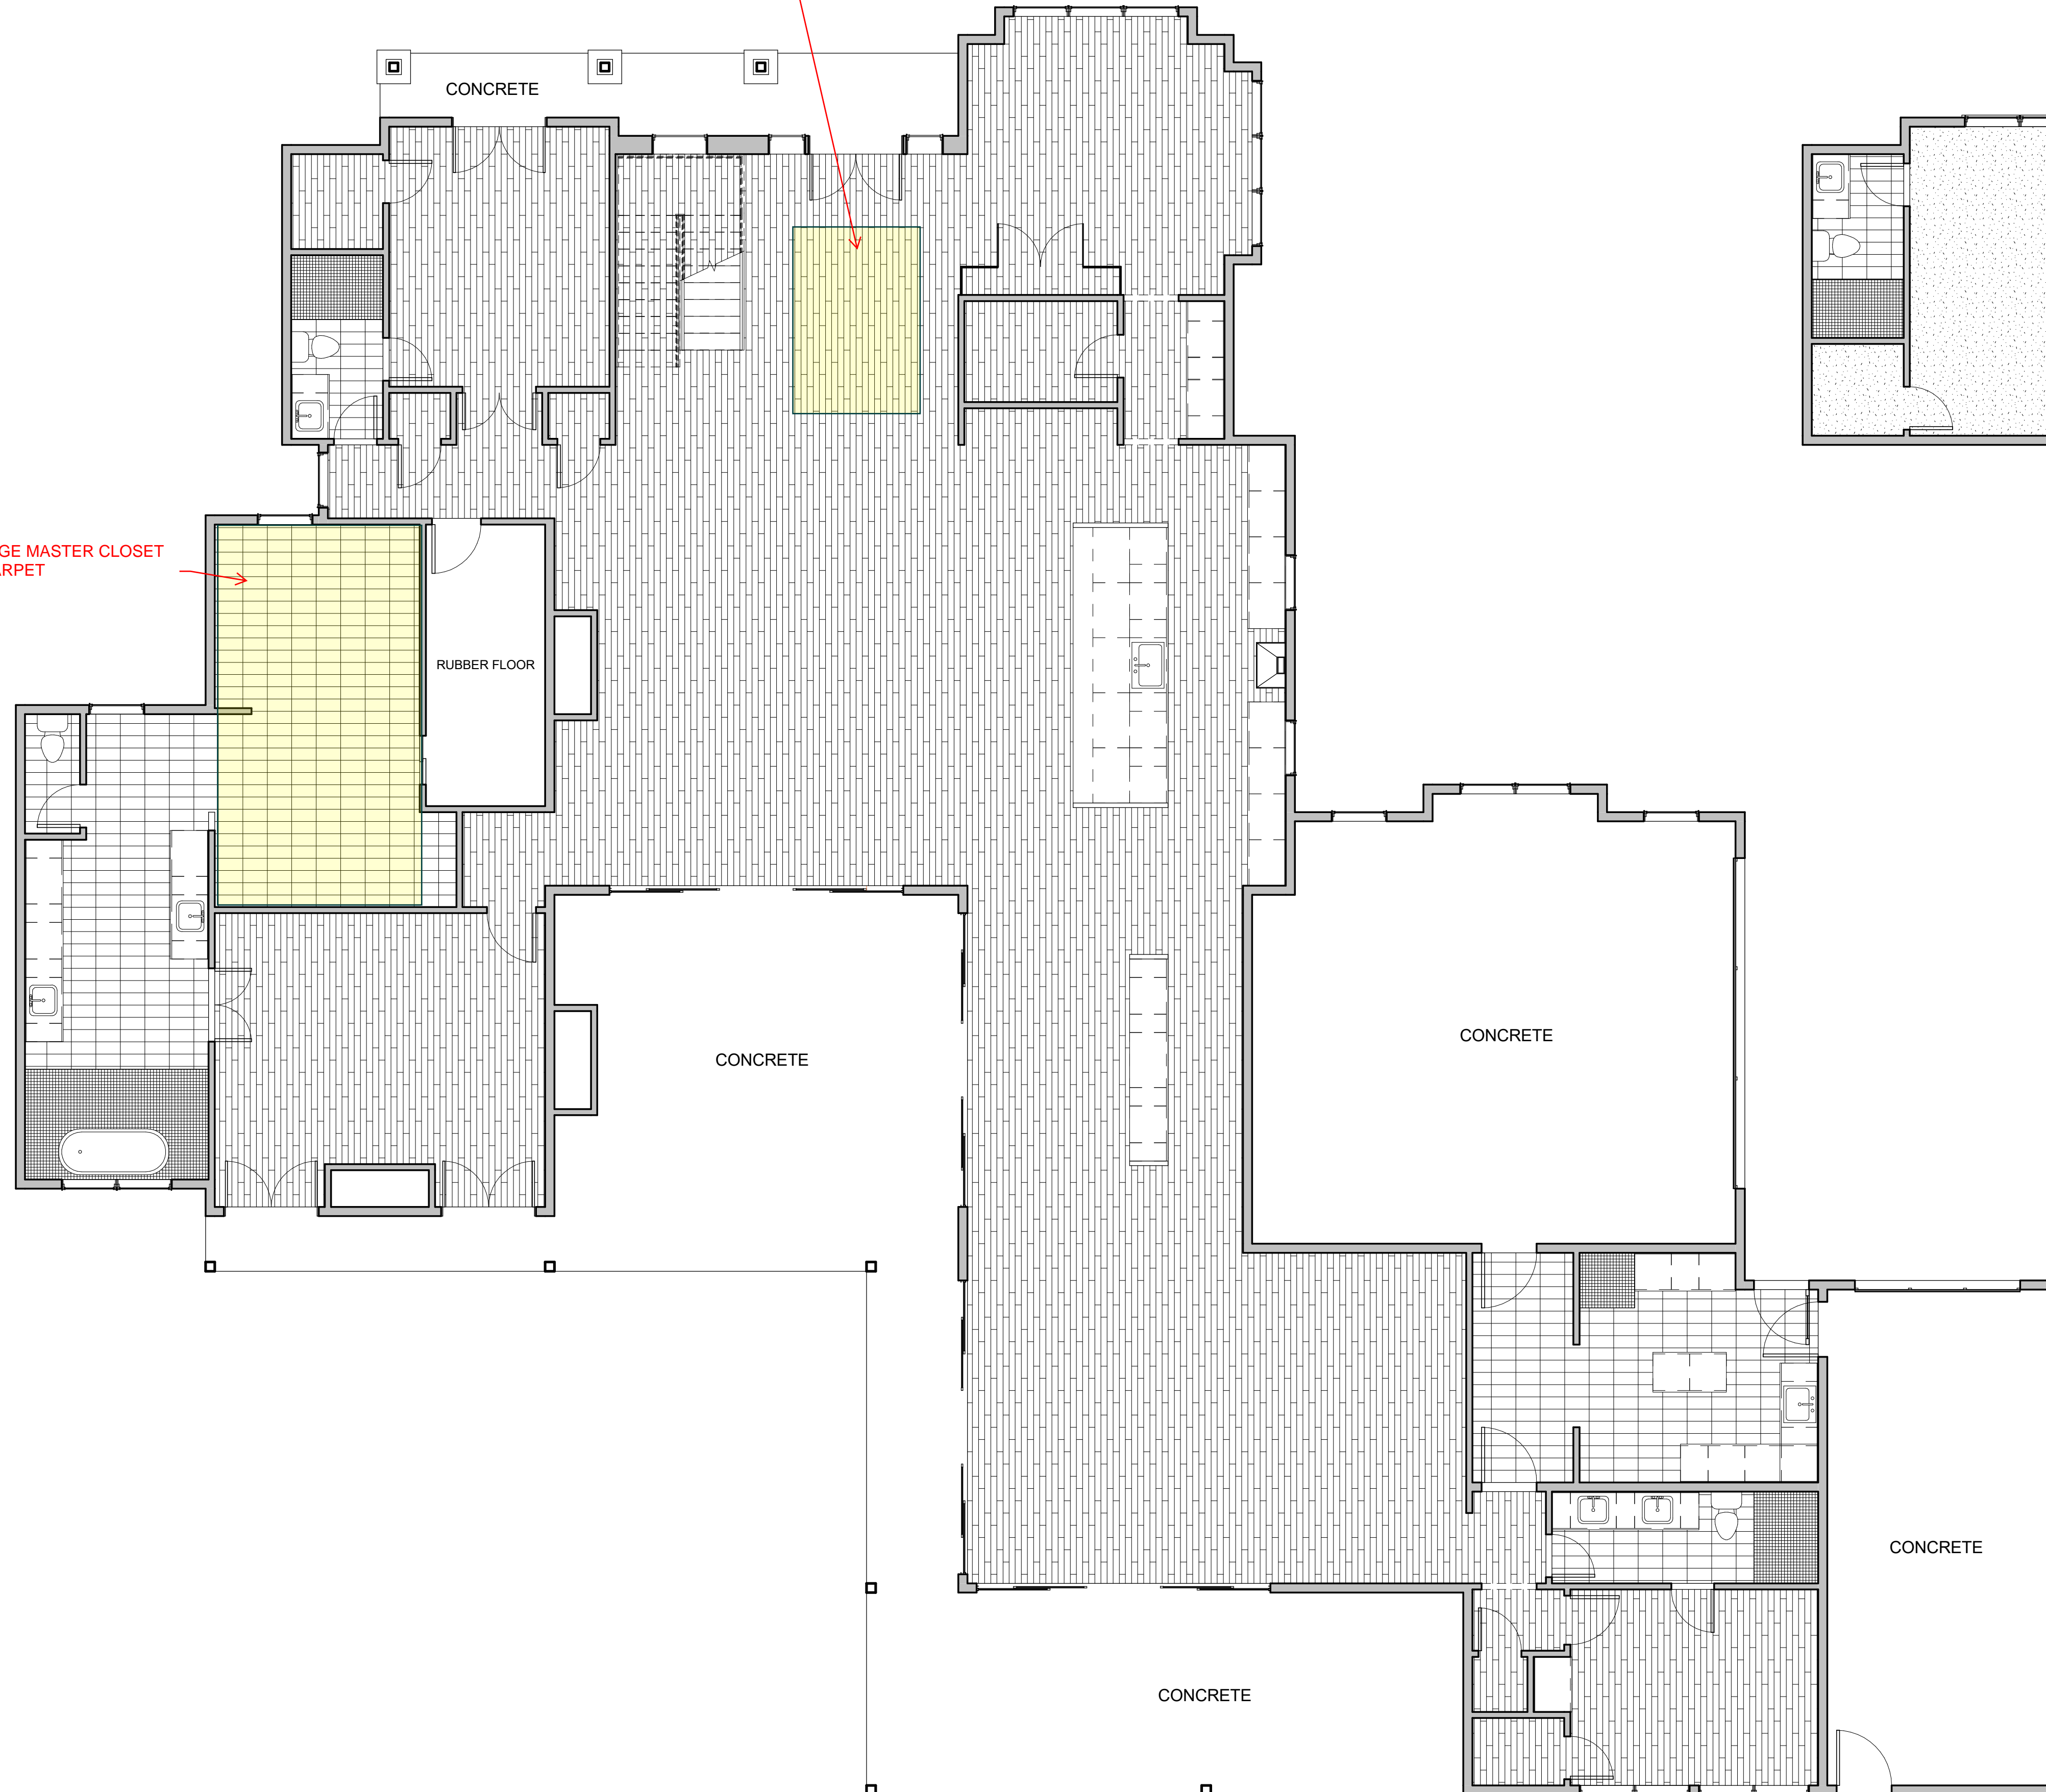

LEVEL 01 - FINISH  
 SCALE: 3/16" = 1'-0"



LEVEL 02 - FINISH  
 SCALE: 3/16" = 1'-0"

503 FRENCHTOWN ROAD  
 ARGYLE, TX 76226

THESE PLANS ARE THE PROPERTY OF RYAN JACOBSON DESIGN LLC AND ARE NOT TO BE REPRODUCED, TRACED, OR REUSED FOR CONSTRUCTION WITHOUT THE WRITTEN PERMISSION OF RYAN JACOBSON DESIGN LLC. THESE PLANS ARE INTENDED TO PROVIDE ALL PROSPECTIVE CONTRACTORS, AND/OR BUILDING MANUFACTURERS THE NECESSARY INFORMATION NEEDED TO DESIGN, BID, AND CONSTRUCT THIS BUILDING. OWNER SHALL VERIFY AND CHECK ALL ASPECTS PRIOR TO ANY CONSTRUCTION. ANY JOBSITE CHANGES WILL VOID DESIGNER'S LIABILITY. DESIGNER'S LIABILITY NOT TO EXCEED FEE PAID FOR PLANS.

No.	Description	Date
1	PERMIT SET	08-30-2021

RYAN JACOBSON DESIGN LLC

ACCNET CONSTRUCTION

LEVEL 1 FINISH PLAN

Project number AC - 1  
 Date 8/30/2021

A05.01

Scale 3/16" = 1'-0"

503 FRENCHTOWN ROAD  
ARGYLE, TX 76226

THESE PLANS ARE THE PROPERTY OF RYAN JACOBSON DESIGN LLC AND ARE NOT TO BE REPRODUCED, TRACED, OR REUSED FOR CONSTRUCTION WITHOUT THE WRITTEN PERMISSION OF RYAN JACOBSON DESIGN LLC. THESE PLANS ARE INTENDED TO PROVIDE ALL PROSPECTIVE CONTRACTORS, AND/OR BUILDING MANUFACTURERS THE NECESSARY INFORMATION NEEDED TO DESIGN, BID, AND CONSTRUCT THIS BUILDING. OWNER SHALL VERIFY AND CHECK ALL ASPECTS PRIOR TO ANY CONSTRUCTION. ANY JOBSITE CHANGES WILL VOID DESIGNER'S LIABILITY. DESIGNER'S LIABILITY NOT TO EXCEED FEE PAID FOR PLANS.

No.	Description	Date
1	PERMIT SET	08-30-2021

RYAN JACOBSON DESIGN LLC


ACCNET CONSTRUCTION

LEVEL 1 POWER PLAN

Project number AC - 1  
Date 8/30/2021

**A10.01**

Scale 3/16" = 1'-0"

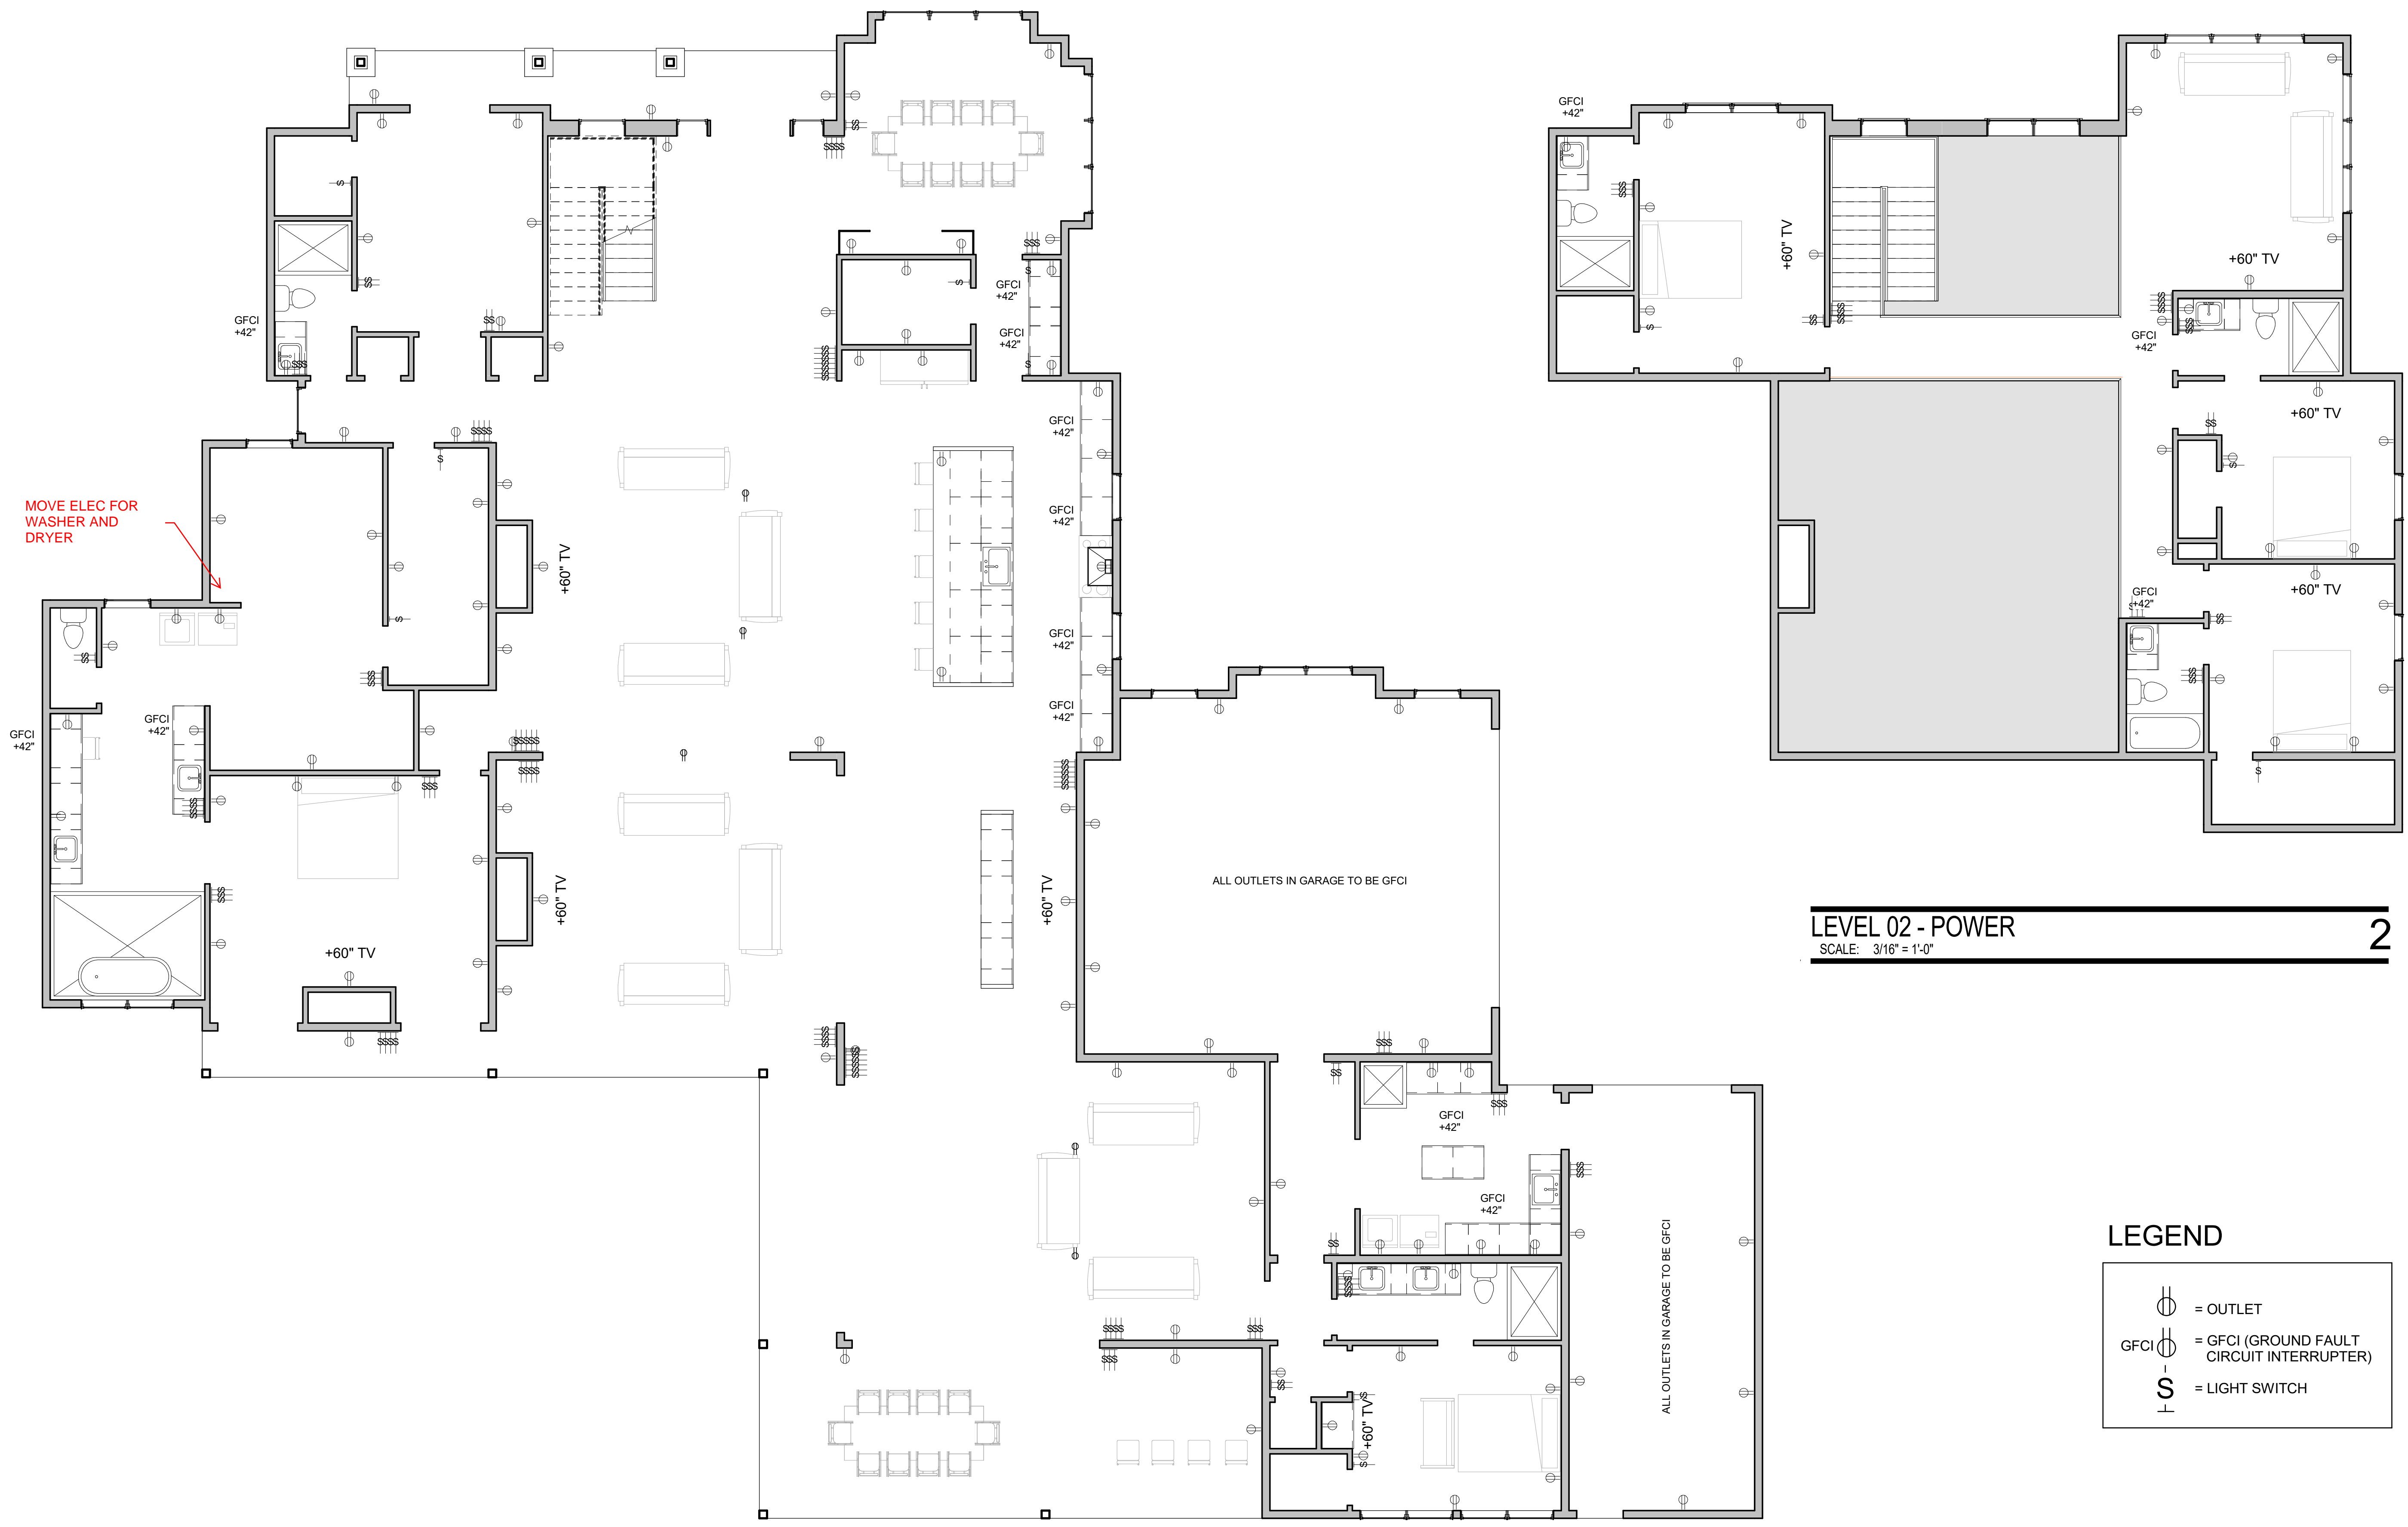

**LEVEL 02 - POWER**  
SCALE: 3/16" = 1'-0" **2**

**LEGEND**

- = OUTLET
- = GFCI (GROUND FAULT CIRCUIT INTERRUPTER)
- = LIGHT SWITCH

**LEVEL 01 - POWER**  
SCALE: 3/16" = 1'-0" **1**